

LINCOLN

91
6/20/78

MISSISSIPPI
BOARD OF WATER COMMISSIONERS
416 North State Street
Jackson, Mississippi 39201

CODED

WATER WELL DRILLERS LOG

June 20 1978 Grenn Water Well Contr. Lincoln
date well completed firm name county well located

LANDOWNER: Robert Earl Watts

Route 5, Box 254
Brookhaven, Miss.

(mailing address)

description of formations encountered

Citronelle

from

1

to

100

WELL LOCATION:

sec. 30 T 7 N R 7 E
S W

6 miles W of Brookhaven
(distance) (direction) (nearest town)

WELL PURPOSE: home
(home, irrigation, municipal, industrial)

WELL COMPLETION DATA:

- (1) diameter (inches) 6"
- (2) total depth (feet) 106
- (3) static water level (feet) 60 below top of ground.
- (4) casing PVC 100'
(material) (depth)
4" If telescope see back.
(size)
- (5) screen 6' 100'
(length) (depth to top)
.010 PVC
(size) (material)
- (6) pump 1/2 HP Sub 10
(HP) (yield gpm)
electricity
(type power)
- (7) electric log no
(yes or no)

(organization running log)

(8) how well bottom plugged
back wash valve

DRILLERS REMARKS:


CODED

RECEIVED
JUL 17 1978

MISS. BD. OF WATER COMM.

If well telescopes please sketch and show depths.

GROUND LEVEL

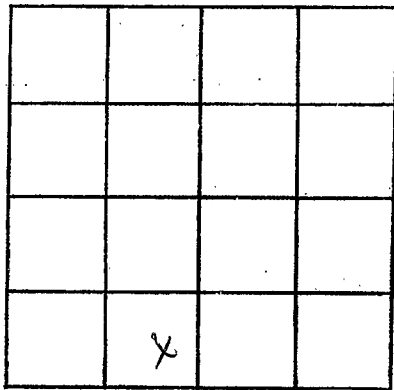

SECTION 50

Please indicate well location X.

ADDITIONAL INFORMATION

Lined area for additional information.

If more than one screen, show locations of each on sketch.