

Lincoln
 G 115
 6-10-77

MISSISSIPPI
 BOARD OF WATER COMMISSIONERS
 416 North State Street
 Jackson, Mississippi 39201

CODED


WATER WELL DRILLERS LOG

June 10 1977 Grenn Water Well Cont. Lincoln
 date well completed firm name county well located

LANDOWNER: Robert Barnes Route 3, Box 43	description of formations encountered Citronelle	from 1	to 133
Brookhaven, Miss. (mailing address)			
WELL LOCATION: sec. 9 T-7 N R-7 E 2 miles NW of Brookhaven (distance) (direction) (nearest town)			
WELL PURPOSE: home (home, irrigation, municipal, industrial)			
WELL COMPLETION DATA:			
(1) diameter (inches) 6			
(2) total depth (feet) 133			
(3) static water level (feet) 40 below top of ground.			
(4) casing PVC 127 (material) (depth) 4" if telescope see back. (size)			
(5) screen 6' 127' (length) (depth to top) .010 PVC (size) (material)			
(6) pump did not install (HP) (yield gpm) (type power)			
(7) electric log no (yes or no) (organization running log)			
(8) how well bottom plugged back wash valve			
DRILLERS REMARKS:			

If well telescopes please sketch and show depths.

GROUND LEVEL

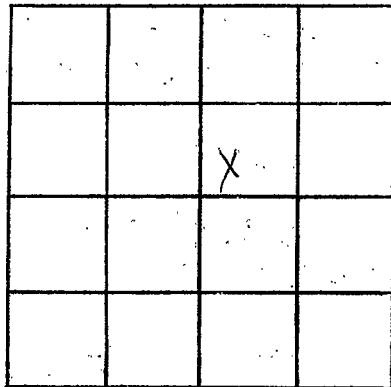

SECTION 9

Please indicate well location X.

ADDITIONAL INFORMATION

Multiple horizontal lines for additional information.

If more than one screen, show locations of each on sketch.