

LINCOLN

G 183

MISSISSIPPI DEPARTMENT OF NATURAL RESOURCES

Bureau of Land and Water Resources

Southport Mall

P.O. Box 10631

Jackson, Mississippi 39209

WATER WELL DRILLERS LOG

CODED

12-7-19 84 date well completed

Gretn Water Well firm name

Lincoln county well located

LANDOWNER: Coleman Lea

description of formations encountered

from to

Rt. 3, Box 79

Citronelle

1 113

Brookhaven, Ms.

(mailing address)

WELL LOCATION:

sec. 1 T 7 N R 7 E S W

CODED

1/2 miles N of Brookhaven (distance) (direction) (nearest town)

WELL PURPOSE: home (home, irrigation, municipal, industrial)

WELL COMPLETION DATA:

- (1) diameter (inches) 4
(2) total depth (feet) 113
(3) static water level (feet) 33 below top of ground.

(4) casing PVC 103' (material) (depth) 4" (size) if telescope see back.

(5) screen 10' 103' (length) (depth to top) .010 PVC (size) (material)

(6) pump did not install (HP) (yield gpm)

(type power)

(7) electric log no (yes or no)

(organization running log)

(8) how well bottom plugged back wash valve

RECEIVED


APR 16 1985

DRILLERS REMARKS:

Department of Natural Resources Bureau of Land & Water Resources

If well telescopes please sketch and show depths.

GROUND LEVEL

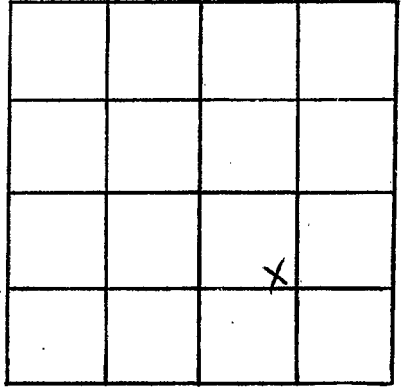

SECTION /

Please indicate well location X.

ADDITIONAL INFORMATION

If more than one screen,
show locations of each on sketch.