

LINCOLN
G 184

MISSISSIPPI DEPARTMENT OF NATURAL RESOURCES
 Bureau of Land and Water Resources
 Southport Mall
 P.O. Box 10631
 Jackson, Mississippi 39209
WATER WELL DRILLERS LOG

CODED

10-4 19 84 Grenn Water Well Lincoln
 date well completed firm name county well located

LANDOWNER: Mississippi Forestry Commission
 908 Robert E. Lee Bldg.
 Jackson, Ms.
 (mailing address)

description of formations encountered	from	to
Citronelle	1	87

WELL LOCATION:
 sec 31 T 7 N R 7 E
 5 miles SW of Brookhaven
 (distance) (direction) (nearest town)

CODED

WELL PURPOSE: fire tower
 (home, irrigation, municipal, industrial)

- WELL COMPLETION DATA:
- (1) diameter (inches) 4
 - (2) total depth (feet) 87
 - (3) static water level (feet) 51 below above top of ground.
 - (4) casing PVC 77' (material) (depth)
 4" (size) if telescope see back.
 - (5) screen 10' 77' (length) (depth to top)
 .010 PVC (size) (material)
 - (6) pump 1/2 sub 10 (HP) (yield gpm)
 electricity (type power)
 - (7) electric log no (yes or no)
 (organization running log)
 - (8) how well bottom plugged back wash valve


RECEIVED

APR 16 1985

DRILLERS REMARKS:

If well telescopes please sketch and show depths.

GROUND LEVEL

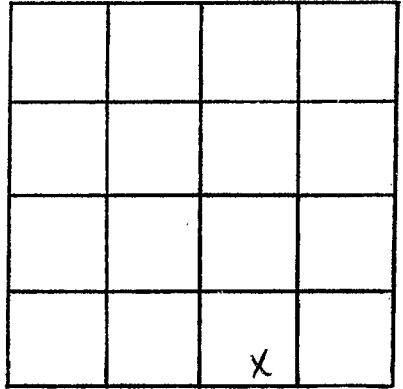

SECTION 31

Please indicate well location X.

ADDITIONAL INFORMATION

If more than one screen,
show locations of each on sketch.