

LINCOLN
G 187

MISSISSIPPI DEPARTMENT OF NATURAL RESOURCES
Bureau of Land and Water Resources
Southport Mall
P.O. Box 10631
Jackson, Mississippi 39209
WATER WELL DRILLERS LOG

CODED

11-77-384 19 Grenn water Well Lincoln
date well completed firm name county well located

LANDOWNER: Clarence Wesse
Rt. 3, Box 791 A
Brookhaven, Ms.
(mailing address)

description of formations encountered	from	to
Citronelle	1	107

WELL LOCATION:
sec. 1 T 7 N R 7 E
S W
1/2 miles N of Brookhaven
(distance) (direction) (nearest town)

CODED

WELL PURPOSE: home
(home, irrigation, municipal, industrial)

- WELL COMPLETION DATA:
- (1) diameter (inches) 4
 - (2) total depth (feet) 107
 - (3) static water level (feet) 35 below above top of ground.
 - (4) casing PVC 97'
(material) (depth)
4" If telescope see back.
(size)
 - (5) screen 10' 97'
(length) (depth to top)
.010 PVC
(size) (material)
 - (6) pump 1/2 sub 10
(HP) (yield gpm)
electricity
(type power)
 - (7) electric log no
(yes or no)
(organization running log)
 - (8) how well bottom plugged -
back wash valve


DRILLERS REMARKS:

RECEIVED
APR 17 1989

Department of Natural Resources
Bureau of Land and Water Resources

If well telescopes please sketch and show depths.

GROUND LEVEL

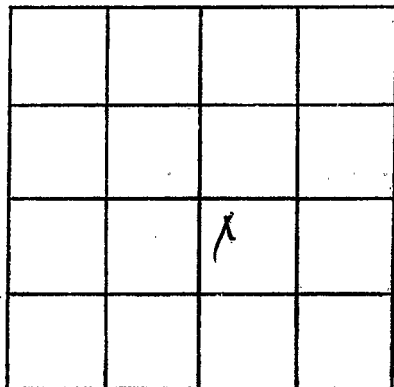

SECTION 1

Please indicate well location X.

ADDITIONAL INFORMATION

If more than one screen,
show locations of each on sketch.