

LINCOLN  
G 188

MISSISSIPPI DEPARTMENT OF NATURAL RESOURCES  
Bureau of Land and Water Resources  
Southport Mall  
P.O. Box 10631  
Jackson, Mississippi 39209  
WATER WELL DRILLERS LOG

CODED

Oct. 29 19 84 Grenn Water Well Lincoln  
date well completed firm name county well located

LANDOWNER: Buddy Price	description of formations encountered	from	to
Rt. 2, Box 613 B		Citronelle	I
Brookhaven, Ms. (mailing address)			
WELL LOCATION:			
sec. 20 T 7 N R 7 E S W			
2 miles SW of Brookhaven (distance) (direction) (nearest town)			
WELL PURPOSE: home (home, irrigation, municipal, industrial)			
WELL COMPLETION DATA:			
(1) diameter (inches) 4			
(2) total depth (feet) 88			
(3) static water level (feet) 57 below top of ground.			
(4) casing PVC 78 (material) (depth) 4" If telescope see back. (size)			
(5) screen 10' 78 (length) (depth to top) .010 PVC (size) (material)			
(6) pump 1/2 sub 10 (HP) (yield gpm) electricity (type power)			
(7) electric log no (yes or no) (organization running log)			
(8) how well bottom plugged back wash valve			

CODED


RECEIVED  
APR 17 1985

DRILLERS REMARKS:

Department of Natural Resources  
Bureau of Land & Water Resources

If well telescopes please sketch and show depths.

GROUND LEVEL

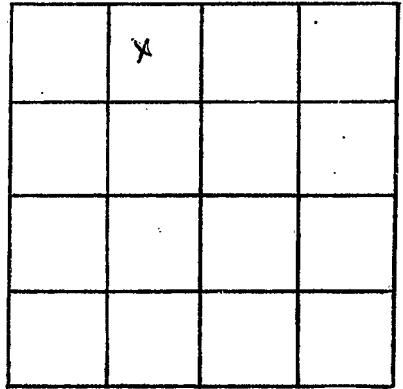

SECTION 20

Please indicate well location X.

ADDITIONAL INFORMATION

If more than one screen,  
show locations of each on sketch.