

LINCOLN
 6189
 4-5-85

MISSISSIPPI DEPARTMENT OF NATURAL RESOURCES
 Bureau of Land and Water Resources
 Southport Mall
 P.O. Box 10631
 Jackson, Mississippi 39209
WATER WELL DRILLERS LOG

4-5 1985 Grenn Water Well Lincoln
 date well completed firm name county well located


LANDOWNER: P. R. Mullikin	description of formations encountered	from	to
604 S. Church St.	Citronelle	1	48
Brookhaven, Ms. (mailing address)			
WELL LOCATION: sec. 27 T 7 N R 7 E S W 2 miles SW of Brookhaven (distance) (direction) (nearest town)			
WELL PURPOSE: home (home, irrigation, municipal, industrial)			
WELL COMPLETION DATA:			
(1) diameter (inches) 4			
(2) total depth (feet) 48			
(3) static water level (feet) 28 below top of ground.			
(4) casing PVC 38' (material) (depth) 4" (size) if telescope see back.			
(5) screen 10' 38' (length) (depth to top) .010 PVC (size) (material)			
(6) pump windmill (HP) (yield gpm) (type power)			
(7) electric log no (yes or no) (organization running log)			
(8) how well bottom plugged back wash valve			

BRITAIN
 MAY 17 1985

DRILLERS REMARKS: Department of Natural Resources Bureau of Land & Water Resources

If well telescopes please sketch and show depths.

GROUND LEVEL

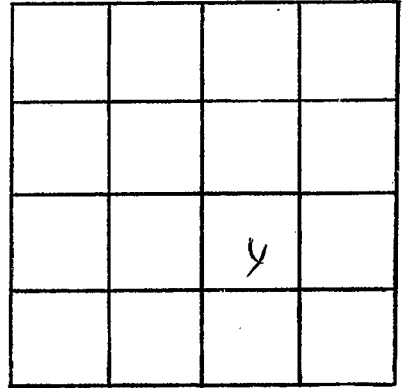

SECTION 27

Please indicate well location X.

ADDITIONAL INFORMATION

If more than one screen,
show locations of each on sketch.