

**MISSISSIPPI DEPARTMENT OF NATURAL RESOURCES**  
**Bureau of Land and Water Resources**  
 Southport Mall  
 P.O. Box 10631  
 Jackson, Mississippi 39209  
**WATER WELL DRILLERS LOG**

LINCOLN  
G 209

6-2 1986 Grenn Water Well Lincoln  
 date well completed firm name county well located

LANDOWNER:	description of formations encountered	from	to
A. C. Lofton	Clay	1	25
Route 5	Sand & gravel	25	85
Brookhaven, Ms.	white clay	85	110
(mailing address)	sand	110	120

SE 1/4

**WELL LOCATION:**  
 sec. 20 T. 7 N. R. 7 E  
                     S                    W  
3 miles SW of Brookhaven  
 (distance) (direction) (nearest town)

**WELL PURPOSE:** home  
 (home, irrigation, municipal, industrial)

- WELL COMPLETION DATA:**
- (1) diameter (inches) 4
  - (2) total depth (feet) 120
  - (3) static water level (feet) 53 below above top of ground.
  - (4) casing PVC 110  
 (material) (depth)  
4"  
 (size) if telescope see back.
  - (5) screen 10' 110'  
 (length) (depth to top)  
.010 PVC  
 (size) (material)
  - (6) pump 1/2 sub 10  
 (HP) (yield gpm)  
electricity  
 (type power)
  - (7) electric log no  
 (yes or no)  
 (organization running log)
  - (8) how well bottom plugged \_\_\_\_\_  
back wash valve


**RECEIVED**  
 JUL 31 1986

Department of Natural Resources  
 Bureau of Land & Water Resources

**DRILLERS REMARKS:**  
 \_\_\_\_\_  
 \_\_\_\_\_  
 \_\_\_\_\_

If well telescopes please sketch and show depths.

GROUND LEVEL

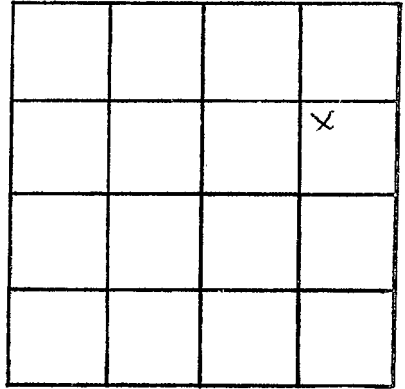

SECTION 20

Please indicate well location X.

ADDITIONAL INFORMATION

If more than one screen,  
show locations of each on sketch.