

MISSISSIPPI DEPARTMENT OF NATURAL RESOURCES
Bureau of Land and Water Resources
 Southport Mall
 P.O. Box 10631
 Jackson, Mississippi 39209
WATER WELL DRILLERS LOG

LINCOLN
G 211

6-18-1986 Grenn Water Well Lincoln
 date well completed firm name county well located

LANDOWNER: A. C. Lofton
 Rt. 5
 Brookhaven, Ms.
 (mailing address)

description of formations encountered	from	to
	Clay	1
sand	20	75
white clay	75	95
blue clay	95	110
white clay	110	115
sand	115	125

WELL LOCATION:
 sec. 20 T 7 N 7 E
 S W
3 miles SW of Brookhaven
 (distance) (direction) (nearest town)

WELL PURPOSE: home
 (home, irrigation, municipal, industrial)

WELL COMPLETION DATA:

- (1) diameter (inches) 4
- (2) total depth (feet) 125
- (3) static water level (feet) 50 below above top of ground.
- (4) casing PVC 115'
 (material) (depth)
4" if telescope see back.
 (size)
- (5) screen 10' 115'
 (length) (depth to top)
.010 PVC
 (size) (material)
- (6) pump 1/2 sub 10
 (HP) (yield gpm)
electricity
 (type power)
- (7) electric log no
 (yes or no)
 (organization running log)
- (8) how well bottom plugged
back wash valve

RECEIVED

JUL 31 1986


Department of Natural Resources
 Bureau of Land & Water Resources

DRILLERS REMARKS:

SENE

If well telescopes please sketch and show depths.

GROUND LEVEL

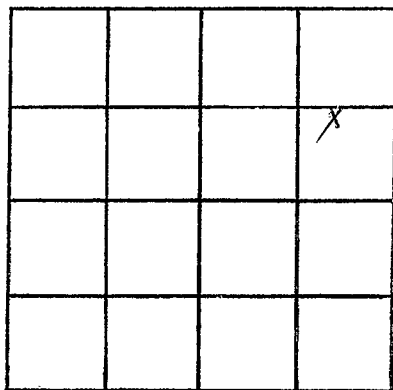

SECTION 20

Please indicate well location X.

ADDITIONAL INFORMATION

If more than one screen, show locations of each on sketch.