

MISSISSIPPI DEPARTMENT OF NATURAL RESOURCES

Bureau of Land and Water Resources

Southport Mall

P.O. Box 10631

Jackson, Mississippi 39209

WATER WELL DRILLERS LOG

LINCOLN
G 219

10-7 1985 Grenn Water Well Lincoln
 date well completed firm name county well located

LANDOWNER: Danny Smith
 Rt. 3, Box 623A
 Brookhaven, Ms.
 (mailing address)

description of formations encountered
 Citronelle
 from 1 to 110

WELL LOCATION:
 SE 6 T 7 N R 7 E
 S W
 3 miles west of Brookhaven
 (distance) (direction) (nearest town)


WELL PURPOSE: home
 (home, irrigation, municipal, industrial)

WELL COMPLETION DATA:

- (1) diameter (inches) 4
- (2) total depth (feet) 110
- (3) static water level (feet) 63 below above top of ground.
- (4) casing PVC, 100' (material), (depth)
 4" if telescope see back. (size)
- (5) screen 10', 100' (length), (depth to top)
 .010 PVC (size), (material)
- (6) pump did not install (HP), (yield gpm)
 (type power)
- (7) electric log no (yes or no)
 (organization running log)

(8) how well bottom plugged
 back wash valve

DRILLERS REMARKS:

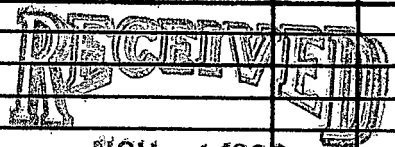


NOV - 4 1985

Department of Natural Resources
 Bureau of Land & Water Resources

If well telescopes please sketch and show depths.

GROUND LEVEL

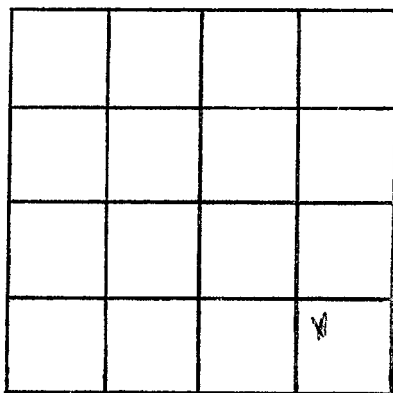

SECTION 12

Please indicate well location X.

ADDITIONAL INFORMATION

If more than one screen,
show locations of each on sketch.