

MISSISSIPPI DEPARTMENT OF NATURAL RESOURCES
Bureau of Land and Water Resources

P.O. Box 10631
Jackson, Mississippi 39209
WATER WELL DRILLERS LOG

COUNTY WELL LOCATED Lincoln	
WELL NUMBER 189753	CODED
G 201	
DATE WELL COMPLETED 7-25-92	

PERMIT NUMBER 510
NAME OF DRILLING FIRM Easley Water Well
Brookhaven, MS 39601

NAME & MAILING ADDRESS OF LANDOWNER Harold Case			
WELL LOCATION: SEC	TOWNSHIP	RANGE	
20	7 ^N _S	7 ^E _W	
DISTANCE	DIRECTION	NEAREST TOWN	
	Miles	of	
OTHER LANDMARK			
WELL PURPOSE: Home, Irrigation, Municipal, Industrial, Fish Pond, etc.			

PUMP DATA		
PUMP TYPE (Circle One): Submersible, Turbine, Jet, Flowing Well, Other (Describe) <u>1/2 HP</u>		
POWER TYPE (Circle One): <u>Electric</u> , Tractor, Diesel, Gasoline, Butane, Other (Describe)		
Pump Capacity (GPM) 106GPM	No. of Stages	Setting Depth FT.
PUMP TEST		
Well yielded GPM with a drawdown of ft. after hours of pumping		

WELL DATA		
Well Depth 100'	Casing Diameter (In.) 4"	Casing Length (Ft.) 80'
Type of Casing PVC	Hole Depth 100'	Depth to Static Water Level
TYPE OF COMPLETION: (Circle One or More): Gravel Packed, Underreamed, Telescoped, Natural Development, Open Hole, Other (Describe) <u>Home</u>		
Top of Lap Pipe or Reduction in Casing FEET IF TELESCOPED OR MORE THAN ONE SCREEN: USE BACK PAGE		

LOG DATA	
TYPE OF LOG RUN (Circle One): No Log Run, Electric, Gamma Ray, Density, Sonic, Neutron, Other (Describe)	
Name of Organization Running Log	

SCREEN DATA		
Diameter - Inches 4"	Length - Feet 20'	Slot Size - Inches 010
Screen Type PVC	Depth to Bottom - Feet 100'	

GEOLOGIC DATA (Office Use Only)			
Surface Elev.	Geologic Unit	Unit Thickness	Depth to Top
Subs. SWL	Date	Analysis	Aquifer Test

Driller's Remarks


DESCRIPTION OF FORMATIONS ENCOUNTERED	FROM	TO	FORMATION (Continued)	FROM	TO
CLAY	0	10	<div style="border: 2px solid black; padding: 5px; display: inline-block;"> RECEIVED JUL 05 1993 </div>		
SAND	10	60			
SAND + Gravel	60	80			
COARSE SAND	80	100			

Dept. of Environmental Quality
Office of Land & Water Resources

IF MORE SPACE IS NEEDED, USE BACK

If well telescopes please
sketch and show depths.

GROUND LEVEL

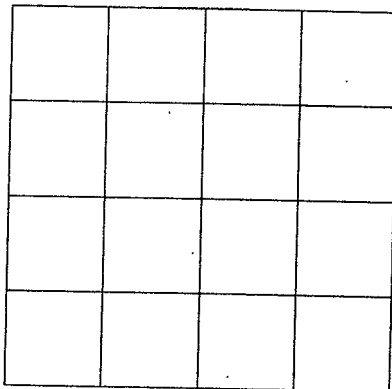

SECTION _____

Please indicate well location X.

ADDITIONAL INFORMATION

If more than one screen,
show location of each on sketch.