

**MISSISSIPPI DEPARTMENT OF ENVIRONMENTAL QUALITY**  
Bureau of Land and Water Resources

P. O. Box 10631  
Jackson, MS 39289-0631  
**WATER WELL DRILLERS LOG**

COUNTY WELL LOCATED <i>Lincoln</i>	
WELL NUMBER <i>G-226</i>	CODED
DATE WELL COMPLETED <i>4-23-92</i>	

PERMIT NUMBER
NAME OF DRILLING FIRM <i>Brown water well &amp; Supply Inc.</i>

NAME & MAILING ADDRESS OF LANDOWNER <i>Sylvia King</i> <i>P.O. Box 982</i> <i>Brookhaven MS</i>		
WELL LOCATION: SEC	TOWNSHIP	RANGE
<i>26</i>	<i>7</i>	<i>7</i>
DISTANCE <i>1</i> Miles	DIRECTION <i>(SW) SW</i>	NEAREST TOWN <i>Brookhaven</i>
OTHER LANDMARK		
WELL PURPOSE <input checked="" type="checkbox"/> Home Irrigation, Municipal, Industrial, Fish Pond, etc.		


<b>PUMP DATA</b>		
PUMP TYPE (Circle One): <input checked="" type="checkbox"/> Submersible, Turbine, Jet, Flowing Well, Other (Describe) _____		
POWER TYPE (Circle One): <input checked="" type="checkbox"/> Electric, Tractor, Diesel, Gasoline, Butane, Other (Describe) _____ H/P <i>1/2</i>		
Pump Capacity (GPM) <i>16</i>	No. of Stages <i>14</i>	Setting Depth <i>85</i> FT.
PUMP TEST		
Well yielded _____ GPM with a drawdown of _____ ft. after _____ hours of pumping		

<b>WELL DATA</b>		
Well Depth <i>190</i>	Casing Diameter (In.) <i>4</i>	Casing Length (Ft.) <i>180</i>
Type of Casing <i>PVC</i>	Hole Depth <i>195</i>	Depth to Static Water Level <i>52</i>
TYPE OF COMPLETION: (Circle One or More): <input checked="" type="checkbox"/> Gravel Packed, Underreamed, Telescoped, Natural Development, Open Hole, Other (Describe) _____		
Top of Lap Pipe or Reduction in Casing FEET IF TELESCOPED OR MORE THAN ONE SCREEN: USE BACK PAGE		

<b>LOG DATA</b>	
TYPE OF LOG RUN (Circle One): <input checked="" type="checkbox"/> No Log Run, Electric, Gamma Ray, Density, Sonic, Neutron, Other (Describe) _____	
Name of Organization Running Log	


<b>SCREEN DATA</b>		
Diameter - Inches <i>4</i>	Length - Feet <i>10</i>	Slot Size - Inches <i>.010</i>
Screen Type <i>PVC</i>	Depth to Bottom - Feet <i>190</i>	

<b>GEOLOGIC DATA (Office Use Only)</b>			
Surface Elev.	Geologic Unit	Unit Thickness	Depth to Top
Subs. SWL	Date	Analysis	Aquifer Test
Driller's Remarks			

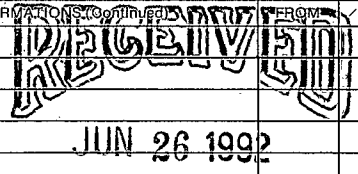DESCRIPTION OF FORMATIONS ENCOUNTERED	FROM	TO	FORMATIONS CONTINUED FROM	TO
<i>Red sandy clay</i>	<i>0</i>	<i>60</i>		
<i>Blue clay</i>	<i>60</i>	<i>130</i>		
<i>Sand</i>	<i>130</i>	<i>195</i>		
<b>Dept. of Environmental Quality</b> <b>Bureau of Land &amp; Water Resources</b>				
IF MORE SPACE IS NEEDED, USE BACK				

If well telescopes please  
sketch and show depths.

GROUND LEVEL

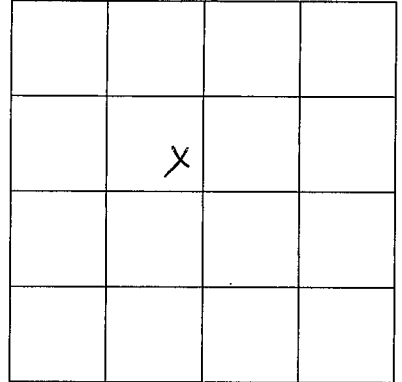

SECTION 26

Please indicate well location X.

ADDITIONAL INFORMATION

If more than one screen,  
show location of each on sketch.