

**MISSISSIPPI DEPARTMENT OF ENVIRONMENTAL QUALITY**  
Bureau of Land and Water Resources

P. O. Box 10631  
Jackson, MS 39289-0631  
**WATER WELL DRILLERS LOG**

COUNTY WELL-LOCATED <i>Lincoln</i>		PERMIT NUMBER
WELL NUMBER <i>G 287</i>	CODED	
DATE WELL COMPLETED <i>2-11-92</i>		NAME OF DRILLING FIRM <i>Dunnitter Well Supply, Inc.</i>

NAME & MAILING ADDRESS OF LANDOWNER <i>Pamela Trullion</i>			
<i>Rt 2</i>			
<i>Brookhaven MS</i>			
WELL LOCATION:	SEC <i>15</i>	TOWNSHIP <i>7 N</i>	RANGE <i>7 E</i>
DISTANCE <i>1/2</i> Miles	DIRECTION <i>W</i>	NEAREST TOWN <i>Brookhaven</i>	
OTHER LANDMARK			
WELL PURPOSE <input checked="" type="checkbox"/> Home Irrigation, Municipal, Industrial, Fish Pond, etc.			

<b>PUMP DATA</b>			
PUMP TYPE (Circle One): <input checked="" type="checkbox"/> Submersible, Turbine, Jet, Flowing Well, Other (Describe)			
POWER TYPE (Circle One): <input checked="" type="checkbox"/> Electric, Tractor, Diesel, Gasoline, Butane, Other (Describe) H/P <i>1/2</i>			
Pump Capacity (GPM) <i>10</i>	No. of Stages <i>9</i>	Setting Depth <i>81</i>	FT.
PUMP TEST			
Well yielded <i>10</i> GPM with a drawdown of <i>0</i> ft. after <i>1/2</i> hours of pumping			

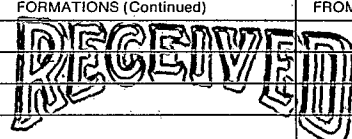
<b>WELL DATA</b>		
Well Depth <i>149</i>	Casing Diameter (In.) <i>4</i>	Casing Length (Ft.) <i>139</i>
Type of Casing <i>PVC</i>	Hole Depth <i>154</i>	Depth to Static Water Level <i>56</i>
TYPE OF COMPLETION: (Circle One or More): <input checked="" type="checkbox"/> Gravel Packed, Underreamed, Telescoped, <input type="checkbox"/> Natural Development, <input type="checkbox"/> Open Hole, <input type="checkbox"/> Other (Describe)		
Top of Lap Pipe or Reduction in Casing		
FEET		
IF TELESCOPED OR MORE THAN ONE SCREEN: USE BACK PAGE		

<b>LOG DATA</b>	
TYPE OF LOG RUN (Circle One): <input checked="" type="checkbox"/> No Log Run, Electric, Gamma Ray, Density, Sonic, Neutron, Other (Describe)	
Name of Organization Running Log	

<b>SCREEN DATA</b>		
Diameter - Inches <i>4</i>	Length - Feet <i>10</i>	Slot Size - Inches <i>.010</i>
Screen Type <i>PVC</i>	Depth to Bottom - Feet <i>149</i>	

<b>GEOLOGIC DATA (Office Use Only)</b>			
Surface Elev.	Geologic Unit	Unit Thickness	Depth to Top
Subs. SWL	Date	Analysis	Aquifer Test

Driller's Remarks

DESCRIPTION OF FORMATIONS ENCOUNTERED	FROM	TO	FORMATIONS (Continued)	FROM	TO
<i>Red sandy clay</i>	<i>0</i>	<i>50</i>	 JUN 26 1992 Dept. of Environmental Quality Bureau of Land & Water Resources		
<i>Gravel</i>	<i>50</i>	<i>55</i>			
<i>sand</i>	<i>55</i>	<i>70</i>			
<i>Clay</i>	<i>70</i>	<i>80</i>			
<i>sand</i>	<i>80</i>	<i>88</i>			
<i>Clay</i>	<i>88</i>	<i>96</i>			
<i>sand</i>	<i>96</i>	<i>100</i>			
<i>Clay</i>	<i>100</i>	<i>102</i>			
<i>sand</i>	<i>102</i>	<i>108</i>			
<i>Clay</i>	<i>108</i>	<i>112</i>			
<i>sand</i>	<i>112</i>	<i>159</i>			

IF MORE SPACE IS NEEDED, USE BACK

If well telescopes please  
sketch and show depths.

GROUND LEVEL

		y	

SECTION 15

Please indicate well location X.

ADDITIONAL INFORMATION

If more than one screen,  
show location of each on sketch.