

**MISSISSIPPI DEPARTMENT OF NATURAL RESOURCES**

Bureau of Land and Water Resources

P.O. Box 10631

Jackson, Mississippi 39209

**WATER WELL DRILLERS LOG**

COUNTY WELL LOCATED <b>Lincoln</b>	
WELL NUMBER <b>G 234</b>	CODED
DATE WELL COMPLETED <b>2-28-91</b>	

PERMIT NUMBER
NAME OF DRILLING FIRM <b>Easley Water Well</b>
<b>Blauw Ms. 39601</b>

NAME & MAILING ADDRESS OF LANDOWNER <b>Alton Kees</b>			
<b>Lincoln</b>			
WELL LOCATION:	SEC	TOWNSHIP	RANGE
	<b>33</b>	<b>7</b> <sup>N</sup> / <sub>S</sub>	<b>7</b> <sup>E</sup> / <sub>W</sub>
DISTANCE	DIRECTION	NEAREST TOWN	
<b>5</b> Miles	<b>West</b>	<b>Brookhaven</b>	
OTHER LANDMARK <b>3 miles west Hickory Hill Gro.</b>			
WELL PURPOSE: Home, Irrigation, Municipal, Industrial, Fish Pond, etc. <b>Home</b>			

<b>PUMP DATA</b>		
PUMP TYPE (Circle One): <u>Submersible</u> Turbine, Jet, Flowing Well, Other (Describe) <b>E HP</b>		
POWER TYPE (Circle One): Electric, Tractor, Diesel, Gasoline, Butane, Other (Describe)		
Pump Capacity (GPM) <b>10</b>	No. of Stages <b>9</b>	Setting Depth <b>9</b> FT.
PUMP TEST		
Well yielded _____ GPM with a drawdown of _____ ft. after _____ hours of pumping		

<b>WELL DATA</b>		
Well Depth <b>90'</b>	Casing Diameter (In.) <b>4"</b>	Casing Length (Ft.) <b>70'</b>
Type of Casing <b>PVC</b>	Hole Depth <b>90'</b>	Depth to Static Water Level:
TYPE OF COMPLETION: (Circle One or More): <u>Natural Development</u> , Gravel Packed, Underreamed, Telescoped, Open Hole, Other		
Top of Lap Pipe or Reduction in Casing <b>FEET</b>		
IF TELESCOPED OR MORE THAN ONE SCREEN: USE BACK PAGE		

<b>LOG DATA</b>	
TYPE OF LOG RUN (Circle One): Electric, Gamma Ray, Density, Sonic, <u>No Log Run</u> , Neutron, Other (Describe)	
Name of Organization Running Log	


<b>SCREEN DATA</b>		
Diameter - Inches <b>4"</b>	Length - Feet <b>20'</b>	Slot Size - Inches <b>0/10</b>
Screen Type <b>PVC</b>	Depth to Bottom - Feet <b>90'</b>	

<b>GEOLOGIC DATA (Office Use Only)</b>			
Surface Elev.	Geologic Unit	Unit Thickness	Depth to Top.
Subs. SWL	Date	Analysis	Aquifer Test
Driller's Remarks			

DESCRIPTION OF FORMATIONS ENCOUNTERED	FROM	TO	FORMATIONS (Continued)	
			FROM	TO
<b>Clay</b>	<b>0ft.</b>	<b>20ft.</b>	<b>RECEIVED</b>	
<b>Sand</b>	<b>20ft.</b>	<b>70ft.</b>		
<b>Coarse Sand</b>	<b>70ft.</b>	<b>90ft.</b>		
			<b>JUN 7 1991</b>	
			Dept. of Environmental Quality Bureau of Land & Water Resources	
			IF MORE SPACE IS NEEDED, USE BACK	

If well telescopes please sketch and show depths.

GROUND LEVEL

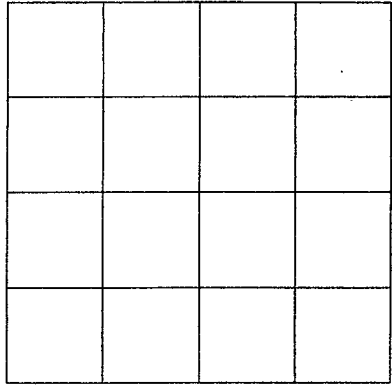

SECTION \_\_\_\_\_

Please indicate well location X.

ADDITIONAL INFORMATION

If more than one screen, show location of each on sketch.