

LINCOLN
G 279

MISSISSIPPI DEPARTMENT OF NATURAL RESOURCES
Bureau of Land and Water Resources
Southport Mall
P.O. Box 10631
Jackson, Mississippi 39209
WATER WELL DRILLERS LOG

7/6 1986 Jerry Guino Water Well Sees Lincoln
date well completed firm name county well located

LANDOWNER: S.P. Woolley
P.O. Box 739
Brookhaven, Ms 39601
(mailing address)

description of formations encountered	from	to
	Clay	0
Sand & Gravel	50	85


WELL LOCATION:
NE 1/4 Sec 14 T 7 N R 7 E
1/2 miles SW of Brookhaven
(distance) (direction) (nearest town)

WELL PURPOSE: Home
(home, irrigation, municipal, industrial)

WELL COMPLETION DATA:

- (1) diameter (inches) 4
- (2) total depth (feet) 85
- (3) static water level (feet) 46 below top of ground.
- (4) casing PVC, 55' (material), (depth)
4" (size) if telescope see back.
- (5) screen 30' 55' (length), (depth to top)
4" (size), PVC (material)
- (6) pump 1/2 5 (HP), (yield gpm)
electricity (type power)
- (7) electric log No (yes or no)
(organization running log)
- (8) how well bottom plugged Backwash Valve


DRILLERS REMARKS:

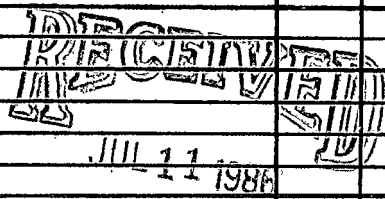

Department of Natural Resources
Bureau of Land & Water Resources

If well telescopes please sketch and show depths.

GROUND LEVEL

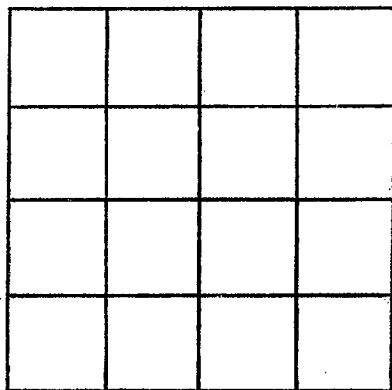

SECTION _____

Please indicate well location X.

ADDITIONAL INFORMATION

If more than one screen,
show locations of each on sketch.