

MISSISSIPPI DEPARTMENT OF NATURAL RESOURCES

Bureau of Land and Water Resources

Southport Mall

P.O. Box 10631

Jackson, Mississippi 39209

WATER WELL DRILLERS LOG

LINCOLN
G 281

Jan 28 1986 Oliver Miller Lincoln
date well completed firm name county well located

LANDOWNER:
Greg Waters
Rt Brookhouser
(mailing address)

description of formations encountered	from	to
<u>clay</u>	<u>0</u>	<u>12</u>
<u>sand & gravel</u>	<u>12</u>	<u>33</u>
<u>white chalk</u>	<u>33</u>	<u>112</u>
<u>sand & gravel</u>	<u>112</u>	<u>125</u>

WELL LOCATION:
sec. 3 T. 7 N R. 7 E
3 miles west of Brookhouser
(distance) (direction) (nearest town)

WELL PURPOSE: Trailer
(home, irrigation, municipal, industrial)

- WELL COMPLETION DATA:
- (1) diameter (inches) 4"
 - (2) total depth (feet) 125
 - (3) static water level (feet) 35 below top of ground.
 - (4) casing plastic bottom
(material) (depth)
 - (size) if telescope see back.
 - (5) screen 5' 120
(length) (depth to top)
 - (size) 4" plastic
(size) (material)
 - (6) pump jet 6
(HP) (yield gpm)
 - (type power) elect
 - (7) electric log no
(yes or no)

RECORDED
INDEXED
JUL 01 1986

Department of Natural Resources
Bureau of Land and Water Resources


(organization running log)

(8) how well bottom plugged
backwash

DRILLERS REMARKS:

If well telescopes please
sketch and show depths.

GROUND LEVEL

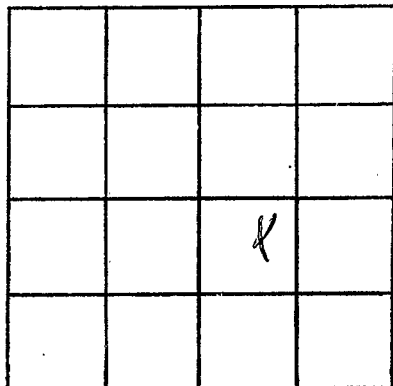

SECTION 3

Please indicate well location X.

ADDITIONAL INFORMATION

If more than one screen,
show locations of each on sketch.