

MISSISSIPPI DEPARTMENT OF NATURAL RESOURCES
Bureau of Land and Water Resources
 Southport Mall
 P.O. Box 10631
 Jackson, Mississippi 39209
WATER WELL DRILLERS LOG

Lincoln
G-232

May 27 19 86 Grenn Water Well Lincoln
 date well completed firm name county well located

LANDOWNER: <u>Roy Lofton</u>	description of formations encountered	from	to
<u>Route 2</u>			
<u>Brookhaven, Ms.</u> (mailing address)	<u>sand & gravel</u>	<u>25</u>	<u>95</u>
	<u>white clay</u>	<u>95</u>	<u>115</u>
	<u>sand</u>	<u>115</u>	<u>120</u>
	<u>white clay</u>	<u>120</u>	<u>122</u>
	<u>sand</u>	<u>122</u>	<u>133</u>
WELL LOCATION:			
<u>Sec. 20 T 7 N R 7 E</u> <u>S W</u>			
<u>3</u> miles <u>West</u> of <u>Brookhaven</u> (distance) (direction) (nearest town)			
WELL PURPOSE: <u>home</u> (home, irrigation, municipal, industrial)			
WELL COMPLETION DATA:			
(1) diameter (inches) <u>4</u>			
(2) total depth (feet) <u>133</u>			
(3) static water level (feet) <u>64</u> below top of ground.			
(4) casing <u>PVC</u> , <u>123</u> (material) (depth)			
<u>4"</u> (size) if telescope see back.			
(5) screen <u>10'</u> , <u>123'</u> (length) (depth to top)			
<u>.010</u> , <u>PVC</u> (size) (material)			
(6) pump <u>did not install</u> ± (HP) (yield gpm)			
(type power)			
(7) electric log <u>no</u> (yes or no)			
(organization running log)			
(8) how well bottom plugged: <u>back wash valve</u>			


RECEIVED
INVESTIGATION
 JUN 27 1986

Department of Natural Resources
 Bureau of Land & Water Resources

DRILLERS REMARKS:

If well telescopes please sketch and show depths.

GROUND LEVEL

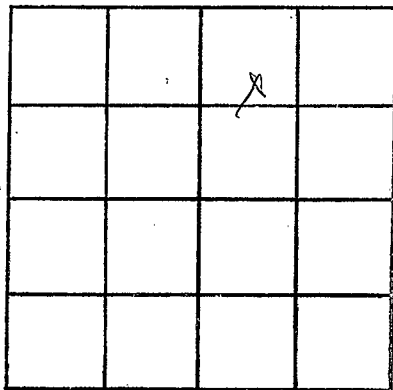

SECTION 20

Please indicate well location X.

ADDITIONAL INFORMATION

If more than one screen, show locations of each on sketch.