

MISSISSIPPI DEPARTMENT OF NATURAL RESOURCES

Bureau of Land and Water Resources

Southport Mall

P.O. Box 10631

Jackson, Mississippi 39209

WATER WELL DRILLERS LOG

Lincoln
G
286

Jan. 13 1986 Grenn Water Well Lincoln
date well completed firm name county well located

LANDOWNER: Ronnie Strain
Rt. 5, Box 555
Brookhaven, Ms.
(mailing address)

| description of formations encountered | from | to |
|---------------------------------------|------------|----|
| | Citronelle | 1 |

WELL LOCATION:
SE NW sec. 34 T. 7 N R. 7 E
S S W W
3 miles SW of Brookhaven
(distance) (direction) (nearest town)

WELL PURPOSE: home
(home, irrigation, municipal, industrial)

WELL COMPLETION DATA:

(1) diameter (inches) 4

(2) total depth (feet) 60

(3) static water level (feet) 33 below above top of ground.

(4) casing PVC 50
(material) (depth)
4" if telescope see back.
(size)

(5) screen 10' 50'
(length) (depth to top)
.010 PVC
(size) (material)

(6) pump 1/2 sub 10
(HP) (yield gpm)
electricity
(type power)

(7) electric log no
(yes or no)

(organization running log)

(8) how well bottom plugged back wash valve


DRILLERS REMARKS:

RECEIVED
FEB 20 1986

Department of Natural Resources
Bureau of Land & Water Resources

If well telescopes please
sketch and show depths.

GROUND LEVEL

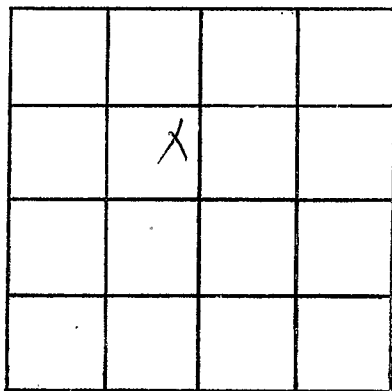

SECTION 34

Please indicate well location X.

ADDITIONAL INFORMATION

If more than one screen,
show locations of each on sketch.