

MISSISSIPPI DEPARTMENT OF NATURAL RESOURCES

Bureau of Land and Water Resources

Southport Mall

P.O. Box 10631

Jackson, Mississippi 39209

WATER WELL DRILLERS LOG

LINCOLN  
CT 288

4-4

19

86 Grenn Water Well

Lincoln

date well completed

firm name

county well located

LANDOWNER: Kevin Thompson

Rt. 2, Box 659B

Brookhaven, Ms.  
(mailing address)

description of formations encountered

from 1 to 45

Citronelle

WELL LOCATION:

sec. 28 T 7 N R 7 E  
S W

3 miles SW of Brookhaven  
(distance) (direction) (nearest town)

WELL PURPOSE: home  
(home, irrigation, municipal, industrial)

WELL COMPLETION DATA:

- (1) diameter (inches) 4
- (2) total depth (feet) 45
- (3) static water level (feet) 17 below above top of ground.
- (4) casing PVC, 35 (material), (depth), 4" (size) if telescope see back.
- (5) screen 10' (length), 35' (depth to top), .010 (size), PVC (material)
- (6) pump 1/2 sub 10 (HP), (yield gpm), electricity (type power)
- (7) electric log no (yes or no)

(organization running log)


(8) how well bottom plugged back wash valve

DRILLERS REMARKS:

RECEIVED  
APR - 8 1988  
Department of Natural Resources  
Bureau of Land & Water Resources

If well telescopes please  
sketch and show depths.

GROUND LEVEL

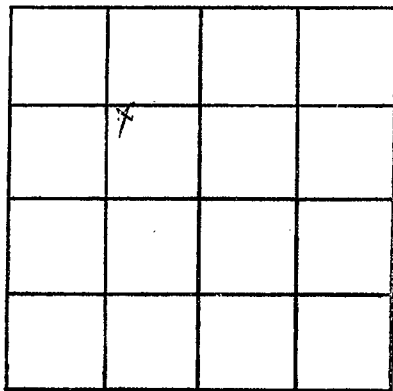

SECTION 28

Please indicate well location X.

ADDITIONAL INFORMATION

If more than one screen,  
show locations of each on sketch.