

LINCOLN
G 289

MISSISSIPPI DEPARTMENT OF NATURAL RESOURCES
Bureau of Land and Water Resources
Southport Mall
P.O. Box 10631
Jackson, Mississippi 39209
WATER WELL DRILLERS LOG

Aug. 1 19 85 Grenn Water Well Lincoln
date well completed firm name county well located

LANDOWNER:
Veterans Administration
100 W. Capital St.
Jackson, Ms.
(mailing address)

description of formations encountered	from	to
Clay	1	15
sand & gravel	15	75
white clay	75	90
blue clay	90	250
sand	260	306


WELL LOCATION:
sec. 6 T. 7 N R. 7 E
S W
4 miles NW of Brookhaven
(distance) (direction) (nearest town)

WELL PURPOSE: home
(home, irrigation, municipal, industrial)

WELL COMPLETION DATA:
(1) diameter (inches) 4
(2) total depth (feet) 306
(3) static water level (feet) 144 below above top of ground.
(4) casing PVC, 296 (material) (depth)
4" (size) if telescope see back.
(5) screen 10' 296' (length) (depth to top)
.010 PVC (size) (material)
(6) pump 1 hp Sub 7 (HP) (yield gpm)
electricity (type power)
(7) electric log no (yes or no)
(organization running log)

(8) how well bottom plugged back wash valve


DRILLERS REMARKS:

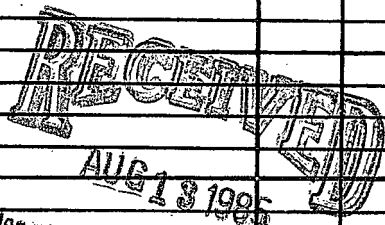

Department of Natural Resources
Bureau of Land & Water Resources

If well telescopes please sketch and show depths.

GROUND LEVEL

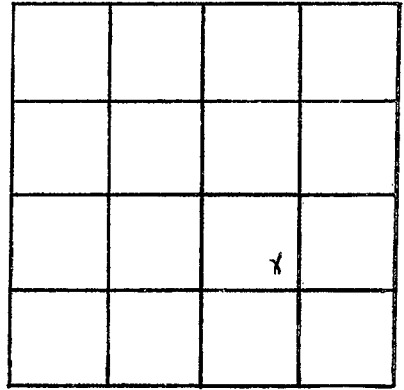

SECTION 6

Please indicate well location X.

ADDITIONAL INFORMATION

If more than one screen,
show locations of each on sketch.