

MISSISSIPPI DEPARTMENT OF NATURAL RESOURCES
 Bureau of Land and Water Resources
 Southport Mall
 P.O. Box 10631
 Jackson, Mississippi 39209
WATER WELL DRILLERS LOG

G 292
 Lincoln
 8-1-85

8-1-1985 Grenn Water Well Lincoln
 date well completed firm name county well located

LANDOWNER: Connie Brown
 Rt. 2,
 Brookhaven, Ms.
 (mailing address)

description of fomations encountered	from	to
Clay	1	80
Sand & Gravel	80	75
white clay	75	95
blue clay	95	145
white clay	145	150
sand	150	163

WELL LOCATION:
 sec. 22 T. 7 N R. 7 E
 S W
 1 miles west of Brookhaven
 (distance) (direction) (nearest town)

WELL PURPOSE: home
 (home, irrigation, municipal, industrial)

WELL COMPLETION DATA:

(1) diameter (inches) 4

(2) total depth (feet) 163

(3) static water level (feet) 63 below top of ground.

(4) casing PVC, 153 (material), (depth)
 4" if telescope see back.
 (size)

(5) screen 10' 153± (length), (depth to top)
 .010 PVC (size), (material)

(6) pump 1/2 sub 8 (HP), (yield gpm)
 electricity (type power)

(7) electric log no (yes or no)
 (organization running log)

(8) how well bottom plugged back wash valve

DRILLERS REMARKS:


RECEIVED

SEP 18 1985

Department of Natural Resources
 Bureau of Land & Water Resources

If well telescopes please sketch and show depths.

GROUND LEVEL

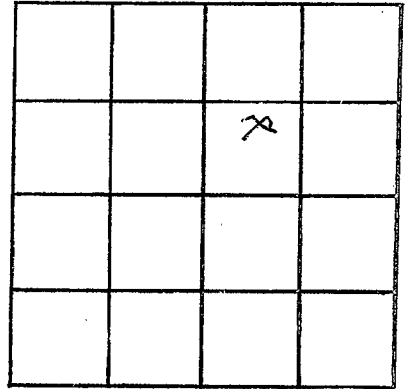

SECTION 22

Please indicate well location X.

ADDITIONAL INFORMATION

If more than one screen,
show locations of each on sketch.