

MISSISSIPPI DEPARTMENT OF NATURAL RESOURCES

Bureau of Land and Water Resources

Southport Mall

P.O. Box 10631

Jackson, Mississippi 39209

WATER WELL DRILLERS LOG

LINCOLN  
G 293

7-6-85

19

Grenn Water Well

Lincoln

date well completed

firm name

county well located

LANDOWNER: Gloria Gayten

Rt. 2

Brookhaven, Ms.

(mailing address)

description of formations encountered

from

to

Clay

1

20

sand & gravel

20

49

white clay

49

100

sand

100

153

WELL LOCATION:

sec. 22 T 7 N R 7 E  
S W

1 miles west of Brookhaven  
(distance) (direction) (nearest town)

WELL PURPOSE: home  
(home, irrigation, municipal, industrial)

WELL COMPLETION DATA:

- (1) diameter (inches) 4
- (2) total depth (feet) 153
- (3) static water level (feet) 49 below above top of ground.
- (4) casing PVC 143'  
(material) (depth)  
4" If telescope see back.  
(size)
- (5) screen 10' 143'  
(length) (depth to top)  
.010 PVC  
(size) (material)
- (6) pump 1/2 sub 7  
(HP) (yield gpm)  
electricity  
(type power)
- (7) electric log no  
(yes or no)  
(organization running log)

(8) how well bottom plugged back wash valve


DRILLERS REMARKS:

RECEIVED  
AUG 13 1985

Department of Natural Resources  
Bureau of Land & Water Resources

If well telescopes please sketch and show depths.

GROUND LEVEL

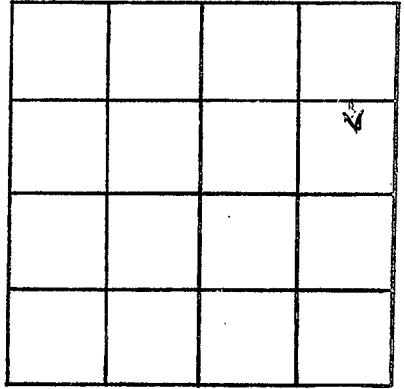

SECTION 22

Please indicate well location X.

ADDITIONAL INFORMATION

If more than one screen,  
show locations of each on sketch.