

LINCOLN
G 296

MISSISSIPPI DEPARTMENT OF NATURAL RESOURCES
Bureau of Land and Water Resources
Southport Mall
P.O. Box 10631
Jackson, Mississippi 39209
WATER WELL DRILLERS LOG

May 17 19 84 Grenn Water Well Lincoln
date well completed firm name county well located

LANDOWNER: Albert Brown
Union St. Ext.
Brookhaven, Ms.
(mailing address)

WELL LOCATION:
sec. 12 T. 7 N R 7 E
S W
1/8 miles N of Brookhaven
(distance) (direction) (nearest town)

WELL PURPOSE: home
(home, irrigation, municipal, industrial)

WELL COMPLETION DATA:

- (1) diameter (inches) 4
(2) total depth (feet) 138
(3) static water level (feet) 57 below above top of ground.
(4) casing PVC 128'
4" (material) (depth)
(size) If telescope see back.
(5) screen 10' 128'
.010 (length) (depth to top)
(size) PVC (material)
(6) pump 1/2 sub 8
(HP) (yield gpm)
electricity
(type power)
(7) electric log no
(yes or no)
(organization running log)
(8) how well bottom plugged.
back wash valve

description of formations encountered	from	to
	Citronelle	1

DEPT. OF NATURAL RESOURCES
BUREAU OF LAND & WATER RESOURCES


JUL 24 1984

RECEIVED

DRILLERS REMARKS:

If well telescopes please sketch and show depths.

GROUND LEVEL

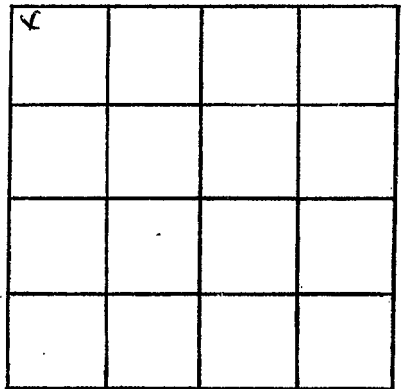

SECTION 12

Please indicate well location X.

ADDITIONAL INFORMATION

If more than one screen,
show locations of each on sketch.