

MISSISSIPPI DEPARTMENT OF NATURAL RESOURCES  
 Bureau of Land and Water Resources  
 Southport Mall  
 P.O. Box 10631  
 Jackson, Mississippi 39209  
**WATER WELL DRILLERS LOG**

Lincoln  
G 297

4-23 1984 Grenn Water Well Lincoln  
 date well completed firm name county well located


LANDOWNER: <u>Fulton Mills</u>	description of formations encountered	from	to
<u>402 Natchez Ave.</u>		Clay	1
<u>Brookhaven, Ms.</u>	sand & gravel	20	60
(mailing address)	white clay	60	100
	sand	100	185
<b>WELL LOCATION:</b>			
sec <u>13</u> T <u>7</u> N R <u>7</u> E			
S W			
<u>Inside city limits Brookhaven</u>			
(distance) miles (direction) of (nearest town)			
<b>WELL PURPOSE:</b> <u>home</u>			
(home, irrigation, municipal, industrial)			
<b>WELL COMPLETION DATA:</b>			
(1) diameter (inches) <u>4</u>			
(2) total depth (feet) <u>185</u>			
(3) static water level (feet) <u>60</u> below top of ground.			
(4) casing <u>PVC</u> <u>165'</u>			
(material) (depth)			
<u>4"</u> if telescope see back.			
(size)			
(5) screen <u>20'</u> <u>165'</u>			
(length) (depth to top)			
<u>.010</u> <u>PVC</u>			
(size) (material)			
(6) pump <u>1 hp sub</u> <u>20</u>			
(HP) (yield gpm)			
<u>electricity</u>			
(type power)			
(7) electric log <u>no</u>			
(yes or no)			
(organization running log)			
(8) how well bottom plugged <u>back wash valve</u>			
<b>DRILLERS REMARKS:</b>			

DEPT. OF NATURAL RESOURCES  
 BUREAU OF LAND & WATER RESOURCES

JUN 11 1984  
**RECEIVED**

If well telescopes please sketch and show depths.

GROUND LEVEL

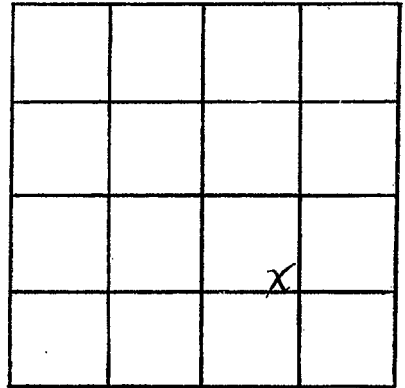

SECTION 13

Please indicate well location X.

ADDITIONAL INFORMATION

If more than one screen,  
show locations of each on sketch.