

Lincoln
 G 298

MISSISSIPPI DEPARTMENT OF NATURAL RESOURCES
 Bureau of Land and Water Resources
 Southport Mall
 P.O. Box 10631
 Jackson, Mississippi 39209
WATER WELL DRILLERS LOG


4-10 1984 Grenn Water Well Lincoln
 date well completed firm name county well located

LANDOWNER: Ricky Ezell	description of formations encountered	from	to
Rt. 7, Box 181 Brookhaven, Ms. (mailing address)			
WELL LOCATION:			
sec. 5 T. 7 N R. 7 E S W			
3 miles W of Brookhaven (distance) (direction) (nearest town)			
WELL PURPOSE: Home (home, irrigation, municipal, industrial)			
WELL COMPLETION DATA:			
(1) diameter (inches) 4			
(2) total depth (feet) 111			
(3) static water level (feet) 60 below above top of ground.			
(4) casing PVC, 101' (material) (depth) 4" if telescope see back. (size)			
(5) screen 10' 101' (length) (depth to top) .010 X PVC (size) (material)			
(6) pump 1/2 sub 8 (HP) (yield gpm) electricity (type power)			
(7) electric log no (yes or no) (organization running log)			
(8) how well bottom plugged back wash valve			
DRILLERS REMARKS:			

MISSISSIPPI DEPARTMENT OF NATURAL RESOURCES
 BUREAU OF LAND & WATER RESOURCES
 RECEIVED JUN 17 1984

If well telescopes please sketch and show depths.

GROUND LEVEL

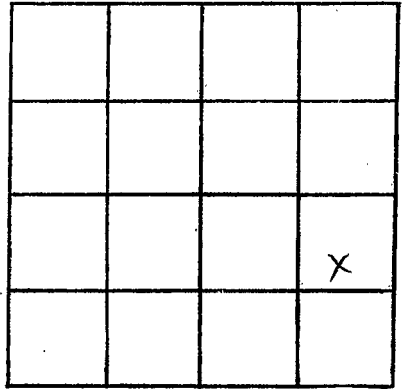

SECTION 5

Please indicate well location X.

ADDITIONAL INFORMATION

If more than one screen,
show locations of each on sketch.