

Paider
G 301

MISSISSIPPI DEPARTMENT OF NATURAL RESOURCES
Bureau of Land and Water Resources
Southport Mall
P.O. Box 10631
Jackson, Mississippi 39209
WATER WELL DRILLERS LOG

4-4 19 84 Gremm Water Well Lincoln
date well completed firm name county well located

LANDOWNER: John Bowers
Rt. 2, Box 109B
Bogue Chitto, Ms.
(mailing address)

description of formations encountered
Citronelle
from 1 to 132

WELL LOCATION:
NW SE sec. 36 T 7 N R 7 E S W
3 miles S of Brookhaven
(distance) (direction) (nearest town)

WELL PURPOSE: home
(home, irrigation, municipal, industrial)

- WELL COMPLETION DATA:
- (1) diameter (inches) 4
 - (2) total depth (feet) 132
 - (3) static water level (feet) 36 below above top of ground.
 - (4) casing PVC, 122' (material), (depth)
4" (size) if telescope see back.
 - (5) screen 10' 122' (length), (depth to top)
.010 PVC (size), (material)
 - (6) pump did not install (HP), (yield gpm)
(type power)
 - (7) electric log no (yes or no)
(organization running log)
 - (8) how well bottom plugged back wash valve


DRILLERS REMARKS:

DEPT. OF NATURAL RESOURCES
BUREAU OF LAND & WATER RESOURCES

JUN 11 1984
RECEIVED

If well telescopes please sketch and show depths.

GROUND LEVEL

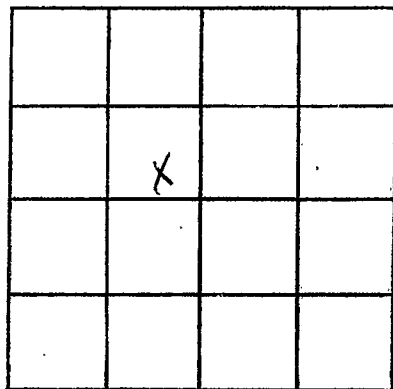

SECTION 36

Please indicate well location X.

ADDITIONAL INFORMATION

If more than one screen,
show locations of each on sketch.