

MISSISSIPPI DEPARTMENT OF NATURAL RESOURCES
 Bureau of Land and Water Resources
 Southport Mall
 P.O. Box 10631
 Jackson, Mississippi 39209
WATER WELL DRILLERS LOG

Landowner
 G 302

12-1 19 83 Grenn Water Well Lincoln
 date well completed firm name county well located

LANDOWNER: Bob Jones
Rt. 2, Box 441
Brookhaven, Ms.
 (mailing address)

description of formations encountered	from	to
Citronelle	1	65

WELL LOCATION:
NENE
 sec. 30 T 7 N R 7 E
 S W
3 miles SW of Brookhaven
 (distance) (direction) (nearest town)

WELL PURPOSE: home
 (home, irrigation, municipal, industrial)

WELL COMPLETION DATA:

(1) diameter (inches) 4

(2) total depth (feet) 65

(3) static water level (feet) 33 below above top of ground.

(4) casing PVC 55'
 (material) (depth)
4"
 (size) if telescope see back.

(5) screen 10' 55'
 (length) (depth to top)
.010 PVC
 (size) (material)

(6) pump 1/2 sub 10
 (HP) (yield gpm)

electricity
 (type power)

(7) electric log no
 (yes or no)

(organization running log)


(8) how well bottom plugged back wash valve

DRILLERS REMARKS:

DEPT. OF NATURAL RESOURCES
 BUREAU OF LAND & WATER RESOURCES
 MAR - 8 1984
RECEIVED

If well telescopes please
sketch and show depths.

GROUND LEVEL

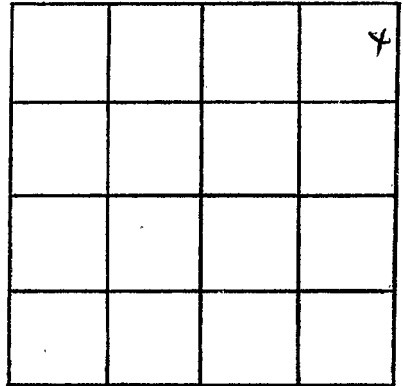

SECTION 30

Please indicate well location X.

ADDITIONAL INFORMATION

If more than one screen,
show locations of each on sketch.