

Lincro
G 303

MISSISSIPPI DEPARTMENT OF NATURAL RESOURCES

Bureau of Land and Water Resources

Southport Mall

P.O. Box 10631

Jackson, Mississippi 39209

WATER WELL DRILLERS LOG

Nov. 7 1983 Ocean Well Service Lincro
date well completed firm name county well located

LANDOWNER:

State Hwy Dept.
Brookhaven
(mailing address)

description of formations encountered

from

to

description of formations encountered	from	to
<u>red clay</u>	<u>0</u>	<u>17</u>
<u>Clay, sand + gravel</u>	<u>17</u>	<u>30</u>
<u>sand + gravel</u>	<u>30</u>	<u>50</u>

WELL LOCATION:

sec. 23 T 7 N R 7 E
3 miles east of Brookhaven
(distance) (direction) (nearest town)

WELL PURPOSE:

shop
(home, irrigation, municipal, industrial)

WELL COMPLETION DATA:

- (1) diameter (inches) 4"
- (2) total depth (feet) 50
- (3) static water level (feet) 30' below above top of ground.
- (4) casing plastic, bottom
(material) (depth)
- If telescope see back.
(size)
- (5) screen 5', 45'
(length) (depth to top)
- 4", plastic
(size) (material)
- (6) pump geather's
(HP) (yield gpm)
- elect
(type power)
- (7) electric log no
(yes or no)
- (organization running log)

(8) how well bottom plugged last wash

DRILLERS REMARKS:


DEPT. OF NATURAL RESOURCES
BUREAU OF LAND & WATER RESOURCES

MAR 15 1984

RECEIVED

If well telescopes please sketch and show depths.

GROUND LEVEL

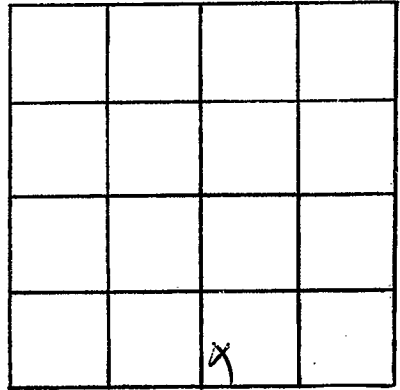

SECTION 23

Please indicate well location X.

ADDITIONAL INFORMATION

If more than one screen,
show locations of each on sketch.