

Lincoln  
G 305

MISSISSIPPI DEPARTMENT OF NATURAL RESOURCES

Bureau of Land and Water Resources

Southport Mall

P.O. Box 10631

Jackson, Mississippi 39209

WATER WELL DRILLERS LOG

Aug 22 1983  
 date well completed

Rees Miller Lincoln  
 firm name

county well located

LANDOWNER:  
Fred Haggat  
Mt. Brookman  
 (mailing address)

description of formations encountered

from to

Clay	0	16
Red cherty sand	16	68
Small gravel sand	68	78

WELL LOCATION:  
 SW NW sec. ~~34~~ 33 T 7 N R 9 E  
3 miles W.S.W. of Brookman  
 (distance) (direction) (nearest town)

WELL PURPOSE: house  
 (home, irrigation, municipal, industrial)

- WELL COMPLETION DATA:
- (1) diameter (inches) 4"
  - (2) total depth (feet) 78'
  - (3) static water level (feet) 53 below above top of ground.
  - (4) casing plaster bottom  
 (material) (depth)
  - if telescope see back.  
 (size)
  - (5) screen 5' 73'  
 (length) (depth to top)
  - 4" plaster  
 (size) (material)
  - (6) pump beathers  
 (HP) (yield gpm)
  - shot  
 (type power)
  - (7) electric log no  
 (yes or no)
  - (organization running log)

(8) how well bottom plugged  
wash wash

DRILLERS REMARKS:  
  


DEPT. OF NATURAL RESOURCES  
 BUREAU OF LAND & WATER RESOURCES

DEC - 7 1983

RECEIVED

If well telescopes please sketch and show depths.

GROUND LEVEL

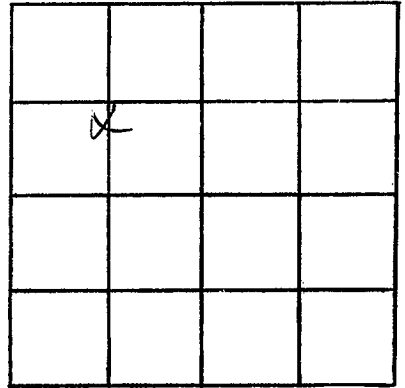

SECTION 34

Please indicate well location X.

ADDITIONAL INFORMATION

If more than one screen,  
show locations of each on sketch.