

MISSISSIPPI DEPARTMENT OF NATURAL RESOURCES

Bureau of Land and Water Resources

Southport Mall

P.O. Box 10631

Jackson, Mississippi 39209

WATER WELL DRILLERS LOG

Lincoln  
G 306

9-16-1983 Gretn Water Well Lincoln  
date well completed firm name county well located

LANDOWNER:	description of formations encountered	from	to
Joe Gibson	Clay	1	20
Rt. 4, Box 150	sand & gravel	20	66
Bogue Chitto, Ms.	white clay	66	80
(mailing address)	blue clay	80	160
WELL LOCATION:	white clay	160	120
sec. <u>34</u> T <u>7</u> N R <u>7</u> E	sand	120	206
S W			
<u>3</u> miles <u>S</u> of <u>Brookhaven</u>			
(distance) (direction) (nearest town)			
WELL PURPOSE: <u>home</u>			
(home, irrigation, municipal, industrial)			
WELL COMPLETION DATA:			
(1) diameter (inches) <u>4</u>			
(2) total depth (feet) <u>206</u>			
(3) static water level (feet) <u>55</u> below above top of ground.			
(4) casing <u>PVC</u> <u>196'</u>			
(material) (depth)			
<u>4"</u> if telescope see back.			
(size)			
(5) screen <u>10'</u> <u>196'</u>			
(length) (depth to top)			
<u>.010</u> <u>PVC</u>			
(size) (material)			
(6) pump <u>2 sub</u> <u>8</u>			
(HP) (yield gpm)			
<u>electricity</u>			
(type power)			
(7) electric log <u>no</u>			
(yes or no)			
<u></u>			
(organization running log)			
(8) how well bottom plugged <u>back wash valve</u>			

DEPT. OF NATURAL RESOURCES  
BUREAU OF LAND & WATER RESOURCES


NOV - 7 1983

RECEIVED

DRILLERS REMARKS:

If well telescopes please sketch and show depths.

GROUND LEVEL

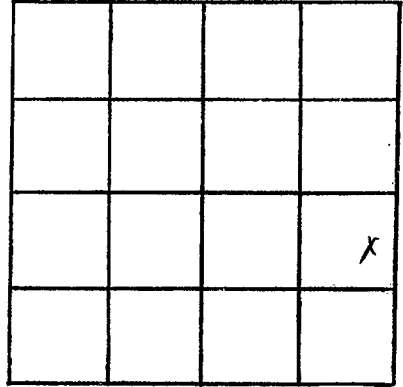

SECTION 34

Please indicate well location X.

ADDITIONAL INFORMATION

If more than one screen,  
show locations of each on sketch.