

Lincoln
6317

MISSISSIPPI DEPARTMENT OF NATURAL RESOURCES
Bureau of Land and Water Resources
Southport Mall
P.O. Box 10631
Jackson, Mississippi 39209
WATER WELL DRILLERS LOG

Aug. 19 82 Grenn Water Well Lincoln
date well completed firm name county well located

LANDOWNER: Travis Tadlock
105 South St.
Brookhaven, Ms.
(mailing address)

description of formations encountered	from	to
<u>Citronelle</u>	<u>1</u>	<u>97</u>

WELL LOCATION:
SE 36 T 7 N R 7 E
S W
2 miles S of Brookhaven
(distance) (direction) (nearest town)

WELL PURPOSE: home
(home, irrigation, municipal, industrial)

WELL COMPLETION DATA:

- (1) diameter (inches) 4
- (2) total depth (feet) 97
- (3) static water level (feet) 41 below above top of ground.
- (4) casing PVC 87
(material) (depth)
4" if telescope see back.
(size)
- (5) screen 10' 87'
(length) (depth to top)
.010 PVC
(size) (material)
- (6) pump 1/2 sub 10
(HP) (yield gpm)
electricity
(type power)
- (7) electric log no
(yes or no)
(organization running log)
- (8) how well bottom plugged _____
back wash valve

DRILLERS REMARKS: _____


DEPT. OF NATURAL RESOURCES
BUREAU OF LAND & WATER RESOURCES

NOV 23 1982

RECEIVED

If well telescopes please sketch and show depths.

GROUND LEVEL

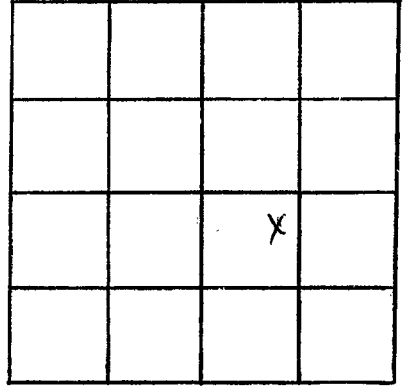

SECTION 36

Please indicate well location X.

ADDITIONAL INFORMATION

If more than one screen,
show locations of each on sketch.