

Lincoln
6318

MISSISSIPPI DEPARTMENT OF NATURAL RESOURCES
 Bureau of Land and Water Resources
 Southport Mall
 P.O. Box 10631
 Jackson, Mississippi 39209
WATER WELL DRILLERS LOG

Aug. 11 1982 Grenn Water Well Lincoln
 date well completed firm name county well located

LANDOWNER: Jay Jackson

Rt. 3, Box 200 C

Brookhaven, Ms.
 (mailing address)

description of formations encountered

Citronelle

from

1

to

106

WELL LOCATION:

NEW
 SE

sec. 5 T 7 N R 7 E
 S S W W
 3 miles W of Brookhaven
 (distance) (direction) (nearest town)

WELL PURPOSE: none
 (home, irrigation, municipal, industrial)

WELL COMPLETION DATA:

- (1) diameter (inches) 4
- (2) total depth (feet) 106
- (3) static water level (feet) 45 below above top of ground.
- (4) casing PVC 96
 (material) (depth)
 4" if telescope see back.
 (size)
- (5) screen 10' 96'
 (length) (depth to top)
 .010 PVC
 (size) (material)
- (6) pump 1/2 sub 8
 (HP) (yield gpm)
 electricity
 (type power)
- (7) electric log no
 (yes or no)

(organization running log)

(8) how well bottom plugged back wash valve

DRILLERS REMARKS:


DEPT. OF NATURAL RESOURCES
 BUREAU OF LAND & WATER RESOURCES

NOV 23 1982

RECEIVED

If well telescopes please sketch and show depths.

GROUND LEVEL

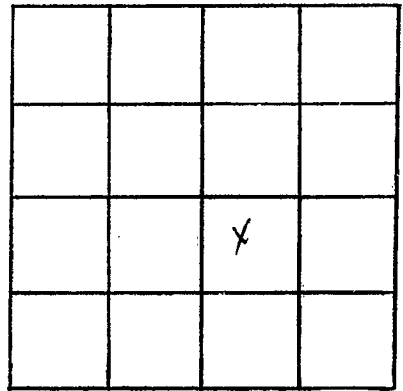

SECTION 5

Please indicate well location X.

ADDITIONAL INFORMATION

If more than one screen,
show locations of each on sketch.