

MISSISSIPPI DEPARTMENT OF NATURAL RESOURCES
Bureau of Land and Water Resources
 Southport Mall
 P.O. Box 10631
 Jackson, Mississippi 39209
WATER WELL DRILLERS LOG

Lincoln
6319

Aug. 6 19 82 Green Water Well Lincoln
 date well completed firm name county well located

LANDOWNER: Ernest D. Smith
Smith's Mobile home
Village, Lot 8
Brookhaven, Ms.
 (mailing address)

description of formations encountered	from	to
	Citronelle	1

WELL LOCATION:
 sec. 3 T 7 N R 7 E
 S W
3 miles NW of Brookhaven
 (distance) (direction) (nearest town)

WELL PURPOSE: home
 (home, irrigation, municipal, industrial)

- WELL COMPLETION DATA:**
- (1) diameter (inches) 4
 - (2) total depth (feet) 110
 - (3) static water level (feet) 45 below above top of ground.
 - (4) casing PVC 100
 (material) (depth)
4" if telescope see back.
 (size)
 - (5) screen 10' 100'
 (length) (depth to top)
.010 PVC
 (size) (material)
 - (6) pump did not install
 (HP) (yield gpm)
 (type power)
 - (7) electric log no
 (yes or no)
 (organization running log)
 - (8) how well bottom plugged back wash valve

DRILLERS REMARKS:


DEPT. OF NATURAL RESOURCES
 BUREAU OF LAND & WATER RESOURCES

NOV 23 1982

RECEIVED

If well telescopes please sketch and show depths.

GROUND LEVEL

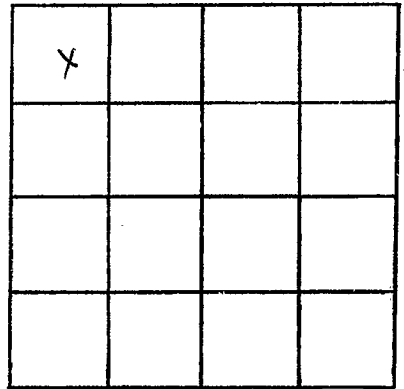

SECTION 6

Please indicate well location X.

ADDITIONAL INFORMATION

If more than one screen,
show locations of each on sketch.