

Lincoln
G 320

MISSISSIPPI DEPARTMENT OF NATURAL RESOURCES
Bureau of Land and Water Resources
Southport Mall
P.O. Box 10631
Jackson, Mississippi 39209
WATER WELL DRILLERS LOG

July 29 1982 Grenn Water Well Lincoln
date well completed firm name county well located

LANDOWNER: Bracey Smith
Route 2, Box 215A
Brookhaven, Ms.
(mailing address)

description of formations encountered
Citronelle

from to
1 85

WELL LOCATION:
sec 20 T 7 N R 7 E
S W
4 miles West of Brookhaven
(distance) (direction) of (nearest town)

WELL PURPOSE: home
(home, irrigation, municipal, industrial)

WELL COMPLETION DATA:

- (1) diameter (inches) 4
- (2) total depth (feet) 85
- (3) static water level (feet) 61 below above top of ground.
- (4) casing PVC 75'
(material) (depth)
4"
(size) if telescope see back.
- (5) screen 10' 75'
(length) (depth to top)
.010 PVC
(size) (material)
- (6) pump did not install
(HP) (yield gpm)

(type power)
- (7) electric log no
(yes or no)

(organization running log)

(8) how well bottom plugged back wash valve

DRILLERS REMARKS:


DEPT. OF NATURAL RESOURCES
BUREAU OF LAND & WATER RESOURCES

SEP 30 1982

RECEIVED

If well telescopes please sketch and show depths.

GROUND LEVEL

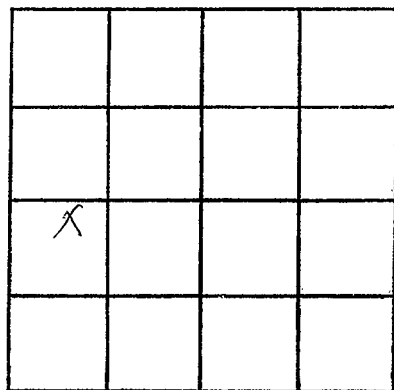

SECTION 20

Please indicate well location X.

ADDITIONAL INFORMATION

If more than one screen, show locations of each on sketch.