

Lincoln  
G 323

MISSISSIPPI DEPARTMENT OF NATURAL RESOURCES  
Bureau of Land and Water Resources  
Southport Mall  
P.O. Box 10631  
Jackson, Mississippi 39209  
WATER WELL DRILLERS LOG

June 23 19 82 Gretn Water Well Lincoln  
date well completed firm name county well located

LANDOWNER: Ronnie Allred  
Route 3  
description of formations encountered Citronelle from 1 to 100

Brookhaven, Ms.  
(mailing address)

WELL LOCATION:  
sec. 18 T 7 N R 7 E  
S W  
4 miles W of Brookhaven  
(distance) (direction) (nearest town)

WELL PURPOSE: home  
(home, irrigation, municipal, industrial)


- WELL COMPLETION DATA:
- (1) diameter (inches) 3
  - (2) total depth (feet) 100
  - (3) static water level (feet) 45 below above top of ground.
  - (4) casing PVC 90  
(material) (depth)  
4" If telescope see back.  
(size)
  - (5) screen 10' 90'  
(length) (depth to top)  
.010 PVC  
(size) (material)
  - (6) pump did not install  
(HP) (yield gpm)  
  
(type power)
  - (7) electric log no  
(yes or no)  
  
(organization running log)
  - (8) how well bottom plugged back wash valve

DRILLERS REMARKS:

DEPT. OF NATURAL RESOURCES  
BUREAU OF LAND & WATER RESOURCES  
AUG 23 1982  
RECEIVED

If well telescopes please sketch and show depths.

GROUND LEVEL

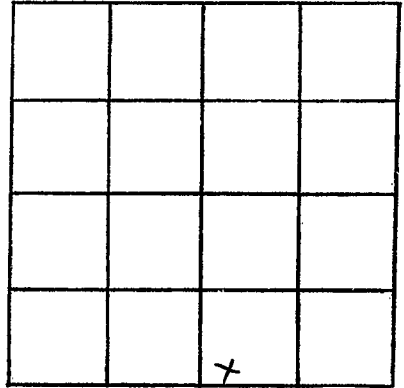

SECTION 18

Please indicate well location X.

ADDITIONAL INFORMATION

If more than one screen,  
show locations of each on sketch.