

MISSISSIPPI DEPARTMENT OF NATURAL RESOURCES
Bureau of Land and Water Resources
 Southport Mall
 P.O. Box 10631
 Jackson, Mississippi 39209
WATER WELL DRILLERS LOG

Lincoln
6326

Feb. 24 1982 Grenn Water Well Lincoln
 date well completed firm name county well located

LANDOWNER: <u>Richard K. Miller</u> <u>Route 3, Box 85 C</u>	description of formations encountered <u>Citronelle</u>	from <u>1</u>	to <u>140</u>
<u>Brookhaven, Ms.</u> (mailing address)			
WELL LOCATION:			
sec <u>8</u> T <u>7</u> N S R <u>7</u> E W			
<u>4</u> miles <u>W</u> of <u>Brookhaven</u> (distance) (direction) (nearest town)			
WELL PURPOSE: <u>4</u> home (home, irrigation, municipal, industrial)			
WELL COMPLETION DATA:			
(1) diameter (inches) <u>4</u>			
(2) total depth (feet) <u>140</u>			
(3) static water level (feet) <u>73</u> below above top of ground.			
(4) casing <u>PVC</u> <u>130'</u> (material) (depth) <u>4"</u> (size) if telescope see back.			
(5) screen <u>10'</u> <u>130'</u> (length) (depth to top) <u>.010</u> <u>PVC</u> (size) (material)			
(6) pump <u>1/2</u> sub <u>8</u> (HP) (yield gpm)			
<u>electricity</u> (type power)			
(7) electric log <u>no</u> (yes or no) (organization running log)			
(8) how well bottom plugged <u>back wash valve</u>			
DRILLERS REMARKS:			


DEPT. OF NATURAL RESOURCES
 BUREAU OF LAND & WATER RESOURCES

MAR 31 1982

RECEIVED

If well telescopes please
sketch and show depths.

GROUND LEVEL

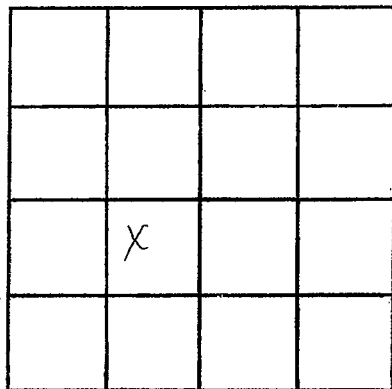

SECTION 8

Please indicate well location X.

ADDITIONAL INFORMATION

If more than one screen,
show locations of each on sketch.