

MISSISSIPPI DEPARTMENT OF NATURAL RESOURCES

Bureau of Land and Water Resources

Southport Mall

P.O. Box 10631

Jackson, Mississippi 39209

WATER WELL DRILLERS LOG

Lincoln  
G 327

Feb-17 1982 News Well Co Lincoln  
date well completed firm name county well located

LANDOWNER:  
Leslon Taylor  
Brookhaven  
(mailing address)

description of formations encountered	from	to
<u>Red sand clay</u>	<u>0</u>	<u>15</u>
<u>Red sand &amp; cholla</u>	<u>15</u>	<u>37</u>
<u>sand</u>	<u>37</u>	<u>60</u>
<u>sand + gravel</u>	<u>60</u>	<u>70</u>

WELL LOCATION:  
SW 34 T 7 N R 7 E  
3 miles W.S.W of Brookhaven  
(distance) (direction) (nearest town)

WELL PURPOSE: house  
(home, irrigation, municipal, industrial)

- WELL COMPLETION DATA:
- (1) diameter (inches) 4"
  - (2) total depth (feet) 70'
  - (3) static water level (feet) 52' above top of ground.
  - (4) casing plastic batton  
(material) (depth)
  - (size) \_\_\_\_\_ if telescope see back.
  - (5) screen 5' 65'  
(length) (depth to top)
  - 4" plastic  
(size) (material)
  - (6) pump sub 10  
(HP) (yield gpm)
  - sub  
(type power)
  - (7) electric log no  
(yes or no)
  - \_\_\_\_\_  
(organization running log)

(8) how well bottom plugged back work

DRILLERS REMARKS:  
\_\_\_\_\_


DEPT. OF NATURAL RESOURCES  
BUREAU OF LAND & WATER RESOURCES

**JUL 15 1982**

**RECEIVED**

If well telescopes please  
sketch and show depths.

GROUND LEVEL

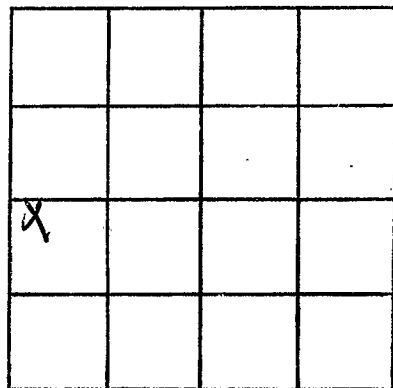

SECTION 34

Please indicate well location X.

ADDITIONAL INFORMATION

If more than one screen,  
show locations of each on sketch.