

Lincoln
G328

MISSISSIPPI DEPARTMENT OF NATURAL RESOURCES
Bureau of Land and Water Resources
Southport Mall
P.O. Box 10631
Jackson, Mississippi 39209
WATER WELL DRILLERS LOG

Jan. 9 1982 Green Water Well Cont. Lincoln
date well completed firm name county well located

LANDOWNER: Pre-Fab Steel, Inc.

P.O. Box 256

Brookhaven, Ms.

(mailing address)

WELL LOCATION:

sec. 20 T 7 N R 7 E
S W
4 miles W of Brookhaven
(distance) (direction) (nearest town)

WELL PURPOSE: Industrial
(home, irrigation, municipal, industrial)

WELL COMPLETION DATA:

- (1) diameter (inches) 4
(2) total depth (feet) 87
(3) static water level (feet) 58 below above top of ground.
(4) casing PVC 77'
(material) (depth)
4" if telescope see back.
(size)
(5) screen 10' 77'
(length) (depth to top)
.010 PVC
(size) (material)
(6) pump 1/2 sub 10
(HP) (yield gpm)
electricity
(type power)
(7) electric log no
(yes or no)

(organization running log)

(8) how well bottom plugged back wash valve

DRILLERS REMARKS:

description of formations encountered
Citronelle

from to
1 87


DEPT. OF NATURAL RESOURCES
BUREAU OF LAND & WATER RESOURCES

FEB 11 1982

RECEIVED

If well telescopes please sketch and show depths.

GROUND LEVEL

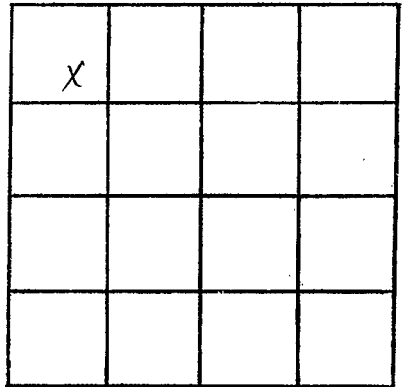

SECTION 20

Please indicate well location X.

ADDITIONAL INFORMATION

If more than one screen,
show locations of each on sketch.