

Lincoln
G-330

MISSISSIPPI DEPARTMENT OF NATURAL RESOURCES
 Bureau of Land and Water Resources
 Southport Mall
 P.O. Box 10631
 Jackson, Mississippi 39209
WATER WELL DRILLERS LOG

Nov. 16 19 81 Grenn Water Well Cont. Lincoln
 date well completed firm name county well located

LANDOWNER: <u>A. C. Scates</u>	description of formations encountered	from	to
<u>P.O. Box 243</u>			
<u>Brookhaven, Ms.</u>	sand & gravel	20	55
(mailing address)	white clay	55	75
	blue clay	75	115
	sand	115	165

WELL LOCATION:
 sec. 13 T 7 N R 7 E
 S W
 inside city limits Brookhaven
 (distance) miles (direction) of (nearest town)

WELL PURPOSE: home
 (home, irrigation, municipal, industrial)

- WELL COMPLETION DATA:
- (1) diameter (inches) 4
 - (2) total depth (feet) 165
 - (3) static water level (feet) 50 below above top of ground.
 - (4) casing PVC 155
 (material) (depth)
4"
 (size) if telescope see back.
 - (5) screen 10' 155'
 (length) (depth to top)
.010 PVC
 (size) (material)
 - (6) pump 1 hp sub. 10
 (HP) (yield gpm)
electricity
 (type power)
 - (7) electric log no
 (yes or no)
(organization running log)
 - (8) how well bottom plugged _____
back wash valve

DRILLERS REMARKS: _____


DEPT. OF NATURAL RESOURCES
 BUREAU OF LAND & WATER RESOURCES

FEB 11 1982

RECEIVED

If well telescopes please sketch and show depths.

GROUND LEVEL

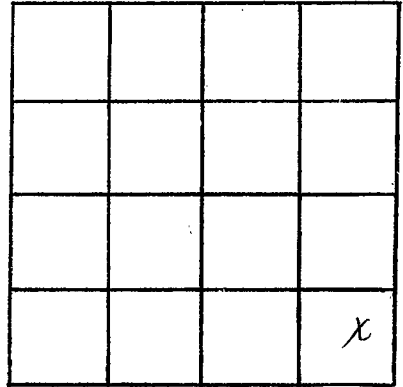

SECTION 13

Please indicate well location X.

ADDITIONAL INFORMATION

If more than one screen,
show locations of each on sketch.