

~~J. H. LINCOLN~~
G 331

MISSISSIPPI DEPARTMENT OF NATURAL RESOURCES
Bureau of Land and Water Resources
Southport Mall
P.O. Box 10631
Jackson, Mississippi 39209
WATER WELL DRILLERS LOG

Nov. 13 1981 Grenn Water Well Cont. Lincoln
date well completed firm name county well located

LANDOWNER: Charles Floyd
Rt. 3, Box 285
Brookhaven, Ms.
(mailing address)

description of formations encountered
Citronelle
from 1 to 73

WELL LOCATION:
sec. 33 T 7 N R 7 E
S W
2 miles SW of Brookhaven
(distance) (direction) (nearest town)

WELL PURPOSE: home
(home, irrigation, municipal, industrial)

WELL COMPLETION DATA:
(1) diameter (inches) 4
(2) total depth (feet) 73
(3) static water level (feet) 47 below above top of ground.
(4) casing PVC 63'
(material) (depth)
4" if telescope see back.
(size)
(5) screen 10' 63'
(length) (depth to top)
1/2" PVC
(size) (material)
(6) pump 1/2 sub 8
(HP) (yield gpm)
electricity
(type power)
(7) electric log no
(yes or no)
(organization running log)

(8) how well bottom plugged
back wash valve

DRILLERS REMARKS:


DEPT. OF NATURAL RESOURCES
BUREAU OF LAND & WATER RESOURCES

FEB 11 1982

RECEIVED

If well telescopes please sketch and show depths.

GROUND LEVEL

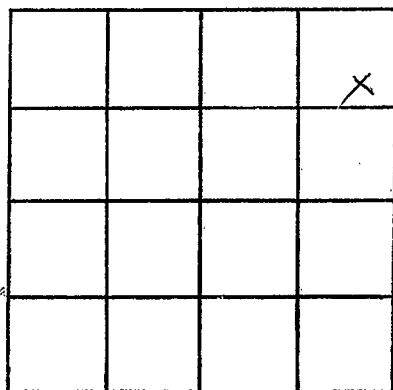

SECTION 33

Please indicate well location X.

ADDITIONAL INFORMATION

If more than one screen,
show locations of each on sketch.