

Lincoln  
G 334  
8-6-81

MISSISSIPPI DEPARTMENT OF NATURAL RESOURCES  
 Bureau of Land and Water Resources  
 Southport Mall  
 P.O. Box 10631  
 Jackson, Mississippi 39209  
**WATER WELL DRILLERS LOG**

Aug. 6 19 81 Grenn Water Well Cont. Lincoln  
 date well completed firm name county well located

LANDOWNER: Johnny Parkman  
P.O. Box 237  
Brookhaven, Ms.  
 (mailing address)

description of formations encountered  
Citonelle  
 from 1 to 165

WELL LOCATION:  
 sec. 25 T 7 N S R 7 E W  
1 miles S of Brookhaven  
 (distance) (direction) (nearest town)

WELL PURPOSE: home  
 (home, irrigation, municipal, industrial)

WELL COMPLETION DATA:  
 (1) diameter (inches) 4  
 (2) total depth (feet) 165  
 (3) static water level (feet) 60 below above top of ground.  
 (4) casing PVC, 155  
 (material) (depth)  
4"  
 (size) if telescope see back.  
 (5) screen 10', 155'  
 (length) (depth to top)  
.010, PVC  
 (size) (material)  
 (6) pump 1/2 sub. 8  
 (HP) (yield gpm)  
electricity  
 (type power)  
 (7) electric log no  
 (yes or no)  
 (organization running log)

(8) how well bottom plugged  
back wash valve

DRILLERS REMARKS: \_\_\_\_\_


DEPT. OF NATURAL RESOURCES  
 BUREAU OF LAND & WATER RESOURCES

OCT - 1 1981

RECEIVED

If well telescopes please sketch and show depths.

GROUND LEVEL

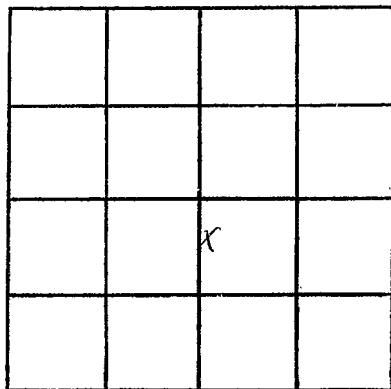

SECTION 20

Please indicate well location X.

ADDITIONAL INFORMATION

If more than one screen,  
show locations of each on sketch.