

MISSISSIPPI DEPARTMENT OF NATURAL RESOURCES
Bureau of Land and Water Resources
 Southport Mall
 P.O. Box 10631
 Jackson, Mississippi 39209
WATER WELL DRILLERS LOG

Lincoln
G 336
6-6-81

June 6 1981 News welder Lincoln
 date well completed firm name county well located

LANDOWNER:
David East
At Brookhaven
 (mailing address)

description of formations encountered	from	to
	<u>Red clay</u>	<u>10</u>
<u>sand & gravel</u>	<u>20</u>	<u>45</u>
<u>Red cherty sand</u>	<u>45</u>	<u>75</u>
<u>coarse sand</u>	<u>75</u>	<u>105</u>

WELL LOCATION:
 sec. 19 T. 7 N. R. 7 E
in miles 3.6 of Zethus
 (distance) (direction) (nearest town)

WELL PURPOSE: home
 (home, irrigation, municipal, industrial)

- WELL COMPLETION DATA:**
- diameter (inches) 4"
 - total depth (feet) 105
 - static water level (feet) 76 below/above top of ground.
 - casing plastic, bottom
 (material) (depth)
 (size) If telescope see back.
 - screen 5' 100'
 (length) (depth to top)
4" plastic
 (size) (material)
 - pump egathon
 (HP) (yield gpm)
stick
 (type power)
 - electric log no
 (yes or no)
 (organization running log)

(8) How well bottom plugged Brookhaven

DRILLERS REMARKS:

81 OCT 2 AB 13

RECEIVED


DEPT. OF NATURAL RESOURCES
 BUREAU OF LAND & WATER RESOURCES

NOV 2 - 1981

RECEIVED

If well telescopes please
sketch and show depths.

GROUND LEVEL

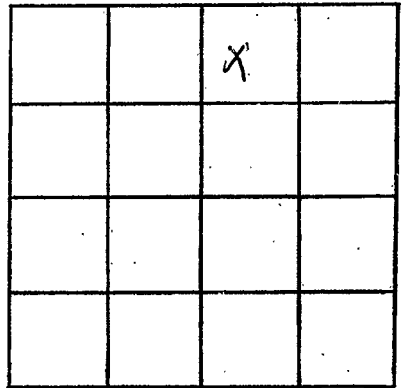

SECTION 19

Please indicate well location X.

ADDITIONAL INFORMATION

If more than one screen,
show locations of each on sketch.