

MISSISSIPPI DEPARTMENT OF NATURAL RESOURCES

Bureau of Land and Water Resources

Southport Mall

P.O. Box 10631

Jackson, Mississippi 39209

WATER WELL DRILLERS LOG

Lincoln
G 338
5-12-81

map 12 1981 Reeves Miller Lincoln
 date well completed firm name county well located

LANDOWNER:
Martha Levi
Brookhaven
 (mailing address)

description of formations encountered	from	to
	<u>Clay</u>	<u>0</u>
<u>Red Chalky sand</u>	<u>22</u>	<u>70</u>
<u>Gravel & sand</u>	<u>70</u>	<u>78</u>

WELL LOCATION:
 NW 9 T. 7 N. R. 7 E
3 miles West of Brookhaven
 (distance) (direction) (nearest town)

WELL PURPOSE: Irrigation
 (home, irrigation, municipal, industrial)

WELL COMPLETION DATA:

(1) diameter (inches) 4"

(2) total depth (feet) 78'

(3) static water level (feet) 61' below/above top of ground.

(4) casing plastic Cotton
 (material) (depth)

(size) If telescope see back.

(5) screen 5' 73'
 (length) (depth to top)

4" plastic
 (size) (material)

(6) pump 1/2 10
 (HP) (yield gpm)

1/2
 (type power)

(7) electric log no
 (yes or no)

(organization running log)

(8) how well bottom plugged
Bochman Valve
 DRILLERS REMARKS:


DEPT. OF NATURAL RESOURCES
 BUREAU OF LAND & WATER RESOURCES

OCT - 1 1981

RECEIVED

If well telescopes please sketch and show depths.

GROUND LEVEL

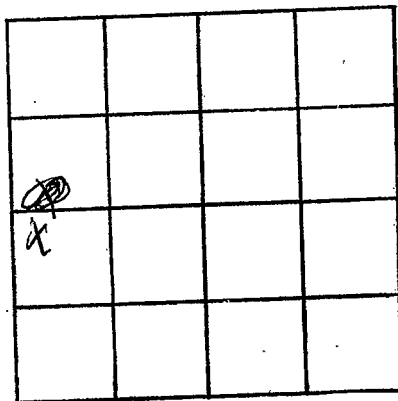

SECTION 9

Please indicate well location X.

ADDITIONAL INFORMATION

Lined area for additional information.

If more than one screen, show locations of each on sketch.