

MISSISSIPPI DEPARTMENT OF NATURAL RESOURCES  
 Bureau of Land and Water Resources  
 Southport Mall  
 P.O. Box 10631  
 Jackson, Mississippi 39209  
**WATER WELL DRILLERS LOG**

Lincoln  
G 337  
5-11-81

May 11 1981 Pennington Miller Lincoln  
 date well completed firm name county well located

LANDOWNER:  
Jimmy Campbell  
Brookhaven  
 (mailing address)

description of formations encountered	from	to
<u>Red Clay</u>	<u>0</u>	<u>17</u>
<u>Red sand</u>	<u>17</u>	<u>48</u>
<u>sandstone</u>	<u>48</u>	<u>65</u>

WELL LOCATION:  
 sec. 21 T-7 N R-7 E  
3 miles west of Brookhaven  
 (distance) (direction) (nearest town)

WELL PURPOSE: private  
 (home, irrigation, municipal, industrial)

- WELL COMPLETION DATA:
- (1) diameter (inches) 4"
  - (2) total depth (feet) 65'
  - (3) static water level (feet) 40' below top of ground.
  - (4) casing plastic bottom  
 (material) (depth)
  - (5) screen 5' 60'  
 (length) (depth to top)
  - (6) pump 4" plastic  
 (size) (material)
  - (7) pump 1/2 10  
 (HP) (yield gpm)
  - (8) electric log no  
 (yes or no)
- (organization running log)

(8) how well bottom plugged  
no

DRILLERS REMARKS:  
no


DEPT. OF NATURAL RESOURCES  
 BUREAU OF LAND & WATER RESOURCES

061-1 1981

RECEIVED

If well telescopes please sketch and show depths.

GROUND LEVEL

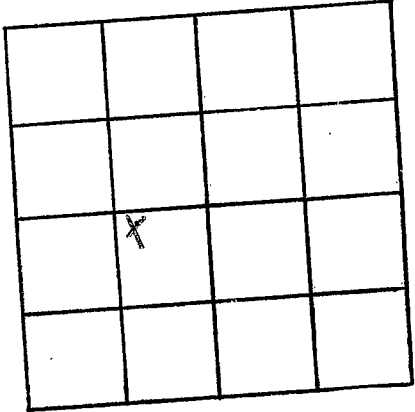

SECTION 21

Please indicate well location X.

ADDITIONAL INFORMATION

Lined area for additional information.

If more than one screen, show locations of each on sketch.