

MISSISSIPPI DEPARTMENT OF NATURAL RESOURCES

Bureau of Land and Water Resources

Southport Mall

P.O. Box 10631

Jackson, Mississippi 39209

WATER WELL DRILLERS LOG

Lincoln
G 340
4-17-81



4-17 1981 CREND LINCOLN
date well completed firm name county well located

LANDOWNER:	description of formations encountered	from	to
KENNETH ROBINSON	CITRONELLE	0	100
(mailing address)			
WELL LOCATION: NW SE sec 30 T 76N R 7E S W 5 miles WEST of BROOKHAVEN (distance) (direction) (nearest town)			
WELL PURPOSE: HOME (home, irrigation, municipal, industrial)			
WELL COMPLETION DATA:			
(1) diameter (inches) 4			
(2) total depth (feet) 100			
(3) static water level (feet) 27 below above top of ground.			
(4) casing pvc 90 (material) (depth) 4 (size) if telescope see back.			
(5) screen 10 90 (length) (depth to top) 4 pvc (size) (material)			
(6) Aer. pump 3/4 8 (HP) (yield gpm) 220 (type power)			
(7) electric log NO (yes or no) (organization running log)			
(8) how well bottom plugged BACK WAS SET VACUUM			

DEPT. OF NATURAL RESOURCES
BUREAU OF LAND & WATER RESOURCES


JUN 5 - 1981

RECEIVED

DRILLERS REMARKS:

If well telescopes please sketch and show depths.

GROUND LEVEL

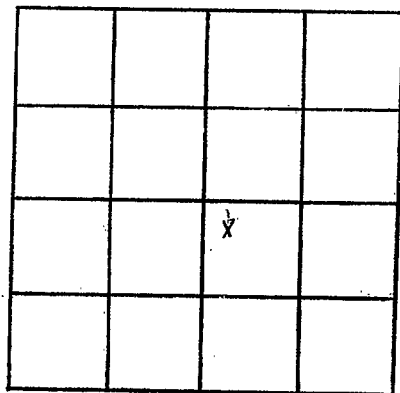

SECTION 30

Please indicate well location X.

ADDITIONAL INFORMATION

If more than one screen, show locations of each on sketch.