

Lincoln
5342
4-3-81

MISSISSIPPI
 BOARD OF WATER COMMISSIONERS
 416 North State Street
 Jackson, Mississippi 39201

WATER WELL DRILLERS LOG

4-3 1981 Grenn Water Well Cont. Lincoln
 date well completed firm name county well located

LANDOWNER: Jack Barrett
Route 2
Brookhaven, Ms.
 (mailing address)

description of formations encountered
Citronelle
 from 1 to 110

WELL LOCATION:
 Ww Se sec. 18 T. 7 N. R. 7 E
 S W
4 miles W of Brookhaven
 (distance) (direction) (nearest town)

WELL PURPOSE: home
 (home, irrigation, municipal, industrial)

- WELL COMPLETION DATA:
- (1) diameter (inches) 4
 - (2) total depth (feet) 110
 - (3) static water level (feet) 50 below above top of ground.
 - (4) casing PVC 100
 (material) (depth)
4"
 (size) if telescope see back.
 - (5) screen 10' 100'
 (length) (depth to top)
.010 PVC
 (size) (material)
 - (6) pump did not install
 (HP) (yield gpm)
 - (type power)
 - (7) electric log no
 (yes or no)
 - (organization running log)
 - (8) how well bottom plugged back wash valve

DRILLERS REMARKS:


DEPT. OF NATURAL RESOURCES
 BUREAU OF LAND & WATER RESOURCES

JUN 5 - 1981

RECEIVED

If well telescopes please sketch and show depths.

GROUND LEVEL

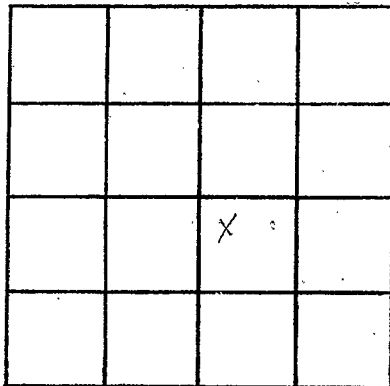

SECTION 18

Please indicate well location X.

ADDITIONAL INFORMATION

If more than one screen,
show locations of each on sketch.