

Lincoln
G 343
3-2-81

MISSISSIPPI DEPARTMENT OF NATURAL RESOURCES
 Bureau of Land and Water Resources
 Southport Mall
 P.O. Box 10631
 Jackson, Mississippi 39209
WATER WELL DRILLERS LOG

March 2, 1981 Green Water Well Cont. Lincoln
 date well completed firm name county well located

LANDOWNER: Larry Webb
P.O. Box 847
Brookhaven, Ms.
 (mailing address)
 WELL LOCATION:
 sec. 36 T 7 N R 7 E
2 S W Brookhaven
 (distance) miles (direction) of (nearest town)

description of formations encountered	from	to
clay	1	20
sand & gravel	20	35
white clay	35	80
blue clay	80	95
white clay	95	110
sand	110	155

WELL PURPOSE: home
 (home, irrigation, municipal, industrial)


- WELL COMPLETION DATA:
- (1) diameter (inches) 4
 - (2) total depth (feet) 155
 - (3) static water level (feet) 35 below above top of ground.
 - (4) casing PVC 145'
 (material) (depth)
4" if telescope see back.
 (size)
 - (5) screen 10' 145'
 (length) (depth to top)
.010 PVC
 (size) (material)
 - (6) pump did not install
 (HP) (yield gpm)
 (type power)
 - (7) electric log no
 (yes or no)
 (organization running log)
 - (8) how well bottom plugged back wash valve

DRILLERS REMARKS:



If well telescopes please sketch and show depths.

GROUND LEVEL

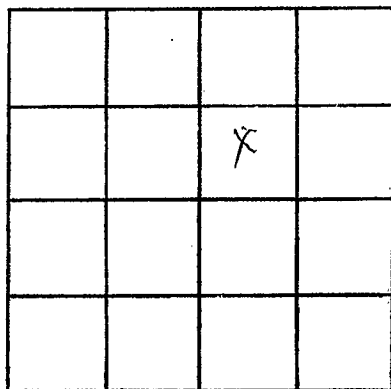

SECTION 56

Please indicate well location X.

ADDITIONAL INFORMATION

If more than one screen, show locations of each on sketch.