

W. N. Nold  
G 346  
10-24-80

MISSISSIPPI  
 BOARD OF WATER COMMISSIONERS  
 416 North State Street  
 Jackson, Mississippi 39201

WATER WELL DRILLERS LOG

10-24-80 19 80 Grenn Water Well Cont. Lincoln  
 date well completed firm name county well located

LANDOWNER: <u>Clarence Hutson</u>	description of fomations encountered	from	to
<u>Brookhaven, Miss.</u>			
(mailing address)	<u>sand &amp; gravel</u>	<u>25</u>	<u>60</u>
WELL LOCATION:	<u>white clay</u>	<u>60</u>	<u>85</u>
sec. <u>22</u> T <u>7</u> N R <u>7</u> E	<u>blue clay</u>	<u>85</u>	<u>115</u>
<u>2</u> miles SW of <u>Brookhaven</u>	<u>white clay</u>	<u>115</u>	<u>129</u>
(distance) (direction) (nearest town)	<u>sand</u>	<u>129</u>	<u>170</u>
WELL PURPOSE: <u>None</u>			
(home, irrigation, municipal, industrial)			
WELL COMPLETION DATA:			
(1) diameter (inches) <u>4</u>			
(2) total depth (feet) <u>170</u>			
(3) static water level (feet) <u>55</u> below top of ground.			
(4) casing <u>PVC</u> <u>160</u>			
(material) (depth)			
<u>4"</u> if telescope see back.			
(size)			
(5) screen <u>10'</u> <u>160'</u>			
(length) (depth to top)			
<u>.010</u> <u>PVC</u>			
(size) (material)			
(6) pump <u>1 sub</u> <u>19</u>			
(HP) (yield gpm)			
<u>electricity</u>			
(type power)			
(7) electric log <u>no</u>			
(yes or no)			
(organization running log)			
(8) how well bottom plugged <u>back wash valve</u>			
DRILLERS REMARKS:			


DEPT. OF NATURAL RESOURCES  
 BUREAU OF LAND & WATER RESOURCES

JAN 12 1981

RECEIVED

If well telescopes please sketch and show depths.

GROUND LEVEL

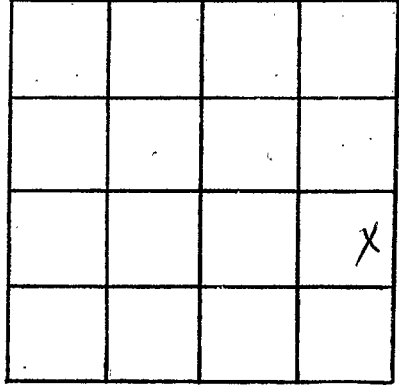

SECTION 22

Please indicate well location X.

ADDITIONAL INFORMATION

If more than one screen,  
show locations of each on sketch.