

Lincoln
G 348
7-16-80

MISSISSIPPI
 BOARD OF WATER COMMISSIONERS
 416 North State Street
 Jackson, Mississippi 39201

WATER WELL DRILLERS LOG

July 16 1980 Grenn Water Well Cont. Lincoln
 date well completed firm name county well located

LANDOWNER: Larry McGee
Route 2
Bogue Chitto, Ms.
 (mailing address)

description of formations encountered
Citronelle
 from 1 to 120

WELL LOCATION:
 sec. 36 T. 7 N R. 7 E
3 miles of Brookhaven
 (distance) (direction) (nearest town)

WELL PURPOSE: home
 (home, irrigation, municipal, industrial)

- WELL COMPLETION DATA:
- (1) diameter (inches) 4
 - (2) total depth (feet) 120
 - (3) static water level (feet) 46 below above top of ground.
 - (4) casing PVC 110
 (material) (depth)
4"
 (size) if telescope see back.
 - (5) screen 10' 110'
 (length) (depth to top)
.010 PVC
 (size) (material)
 - (6) pump 1/2 Sub 10
 (HP) (yield gpm)
electricity
 (type power)
 - (7) electric log no
 (yes or no)
(organization running log)


DEPT. OF NATURAL RESOURCES
 BUREAU OF LAND & WATER RESOURCES
 OCT 23 1980

RECEIVED

(8) how well bottom plugged
back wash valve
 DRILLERS REMARKS:

If well telescopes please sketch and show depths.

GROUND LEVEL

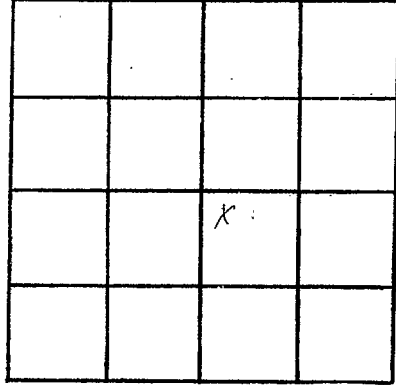

SECTION 36

Please indicate well location X.

ADDITIONAL INFORMATION

If more than one screen, show locations of each on sketch.