

Lincoln
 G 349
 7-9-80

MISSISSIPPI
 BOARD OF WATER COMMISSIONERS
 416 North State Street
 Jackson, Mississippi 39201

WATER WELL DRILLERS LOG

July 9 1980 Grenn Water Well Cont. Lincoln
 date well completed firm name county well located

| LANDOWNER: | description of formations encountered | from | to |
|--|---------------------------------------|------|----|
| William Allgood Route 4 | Citronelle | 1 | 88 |
| Brookhaven, Ms. (mailing address) | | | |
| WELL LOCATION: sec. 34 T 7 N R 7 E 2 miles SW of Brookhaven (distance) (direction) (nearest town) | | | |
| WELL PURPOSE: home (home, irrigation, municipal, industrial) | | | |
| WELL COMPLETION DATA: | | | |
| (1) diameter (inches) 4 | | | |
| (2) total depth (feet) 88 | | | |
| (3) static water level (feet) 55 below top of ground | | | |
| (4) casing PVC 78' (material) (depth) 4" if telescope see back. (size) | | | |
| (5) screen 10' 78' (length) (depth to top) .010 PVC (size) (material) | | | |
| (6) pump 1/2 sub 8 (HP) (yield gpm) electricity (type power) | | | |
| (7) electric log no (yes or no) | | | |
| (organization running log) | | | |
| (8) how well bottom plugged backwash valve | | | |
| DRILLERS REMARKS: | | | |


DEPT. OF NATURAL RESOURCES
 BUREAU OF LAND & WATER RESOURCES

AUG 18 1980

RECEIVED

If well telescopes please sketch and show depths.

GROUND LEVEL

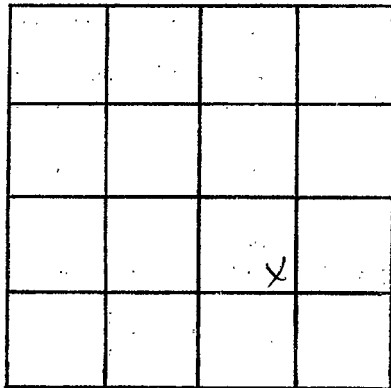

SECTION 34

Please indicate well location X.

ADDITIONAL INFORMATION

If more than one screen, show locations of each on sketch.